

CORNER RECORD


Document Number CR-01-138

City of _____

County of San Joaquin, California

Brief Legal Description EIGHT MILE ROAD

SW CORNER OF SE 1/4 OF SECTION 32, T.3N.,R.6E.

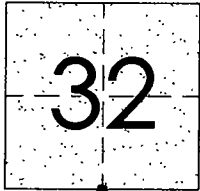

CORNER TYPE

Government Corner Control
Meander Property
Rancho Other

Date of Survey SEPTEMBER 21, 2001

COORDINATES (Optional)

N. _____
E. _____
Zone _____ NAD27 NAD83
NAD83 Epoch _____
Elev. _____
Vert. Datum: NGVD29 NAVD88
Meas. Units: Metric Imperial

Corner - Left as found Found and tagged Established Reestablished Rebuilt

Identification and type of corner found: Evidence used to identify or procedure used to establish or reestablish the corner:
FOUND BOLT AND WASHER. CONFIRMED LOCATION PER SWING TIES ON CR-00-277. SEE SKETCH ON BACKSIDE.

A description of the physical condition of the monument as found and as set or reset:
FOUND MONUMENT IN GOOD CONDITION. SEE SKETCH ON BACKSIDE.

SURVEYOR'S STATEMENT

This Corner Record was prepared by me or under my direction in conformance with the Land Surveyors' Act on OCTOBER 29, 2001.

Signed Manuel Alvarez Solario LS. or R.C.E. Number C30890




COUNTY SURVEYOR'S STATEMENT


This Corner Record was received October 30, 2001 and examined and filed November 7, 2001.

Signed Thomas M. Gau R.C.E. No. 26994

for Title Interim County Surveyor

County Surveyor's Comment _____

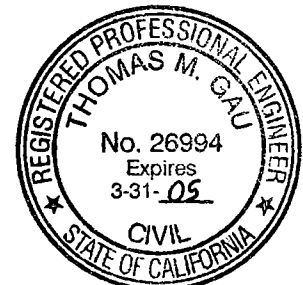

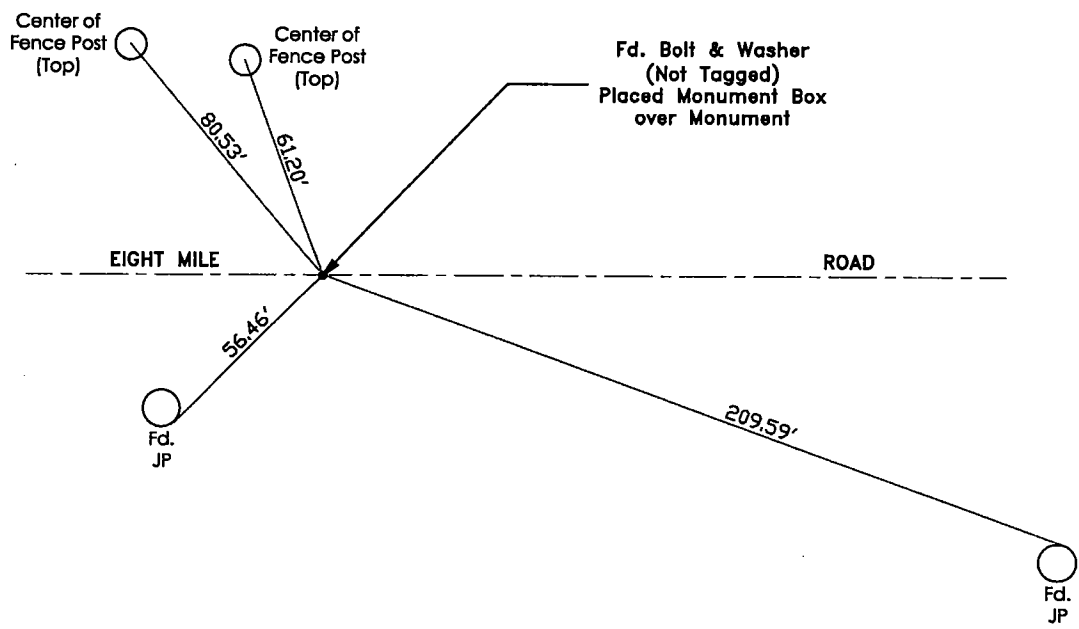

"No Attempt Was Made To Verify Monument(s)"

- FP=Fence Post
- GP=Guy Post
- JP=Joint Pole
- PP=Power Pole
- SP=Service Pole
- TP=Telephone Pole
- N.T.S.=Not To Scale
- Fd.=Conc. Nails with Brass Washers Stamped "S.J. Co.", unless otherwise noted