


CORNER RECORD

City of _____

Document Number 00-109
County of San Joaquin, California

Brief Legal Description AT THE INTERSECTION OF HARNEY LANE AND
CURRY AVE. SOUTH PER. P.M. 18-73

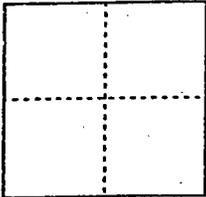

CORNER TYPE

- Government Corner Control
- Meander Property
- Rancho Other

Date of Survey 12-30-99

COORDINATES (Optional)

N. _____
 E. _____
 Zone _____ NAD27 NAD83
 NAD83 Epoch _____
 Elev. _____
 Vert. Datum: NGVD29 NAVD88
 Meas. Units: Metric Imperial

Corner - Left as found Found and tagged Established Reestablished Rebuilt

Identification and type of corner found: Evidence used to identify or procedure used to establish or reestablish the corner:


FOUND SHIP SPIKE PER P.M.
18-73 PER SWING TIES ON C.R.00-72. SEE SKETCH ON
BACKSIDE.

A description of the physical condition of the monument as found and as set or reset: FOUND SHIP SPIKE
PER. P.M. 18-73 IN GOOD CONDITION AND PLACED A
MONUMENT WELL OVER MONUMENT.

SURVEYOR'S STATEMENT

This Corner Record was prepared by me or under my direction in conformance with the Land Surveyors' Act on Feb 11, 2000.

Signed _____ L.S. or R.C.E. Number 23341

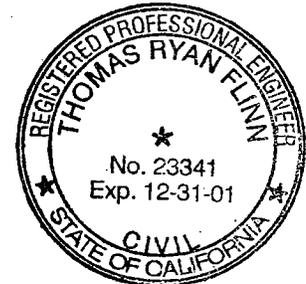


COUNTY SURVEYOR'S STATEMENT


This Corner Record was received 2-15, 2000 and examined and filed 2-15, 2000.

Signed Henry M. Hirata R.C.E. No. 21258

Title _____ County Surveyor

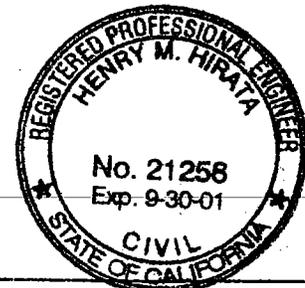

County Surveyors Comment _____

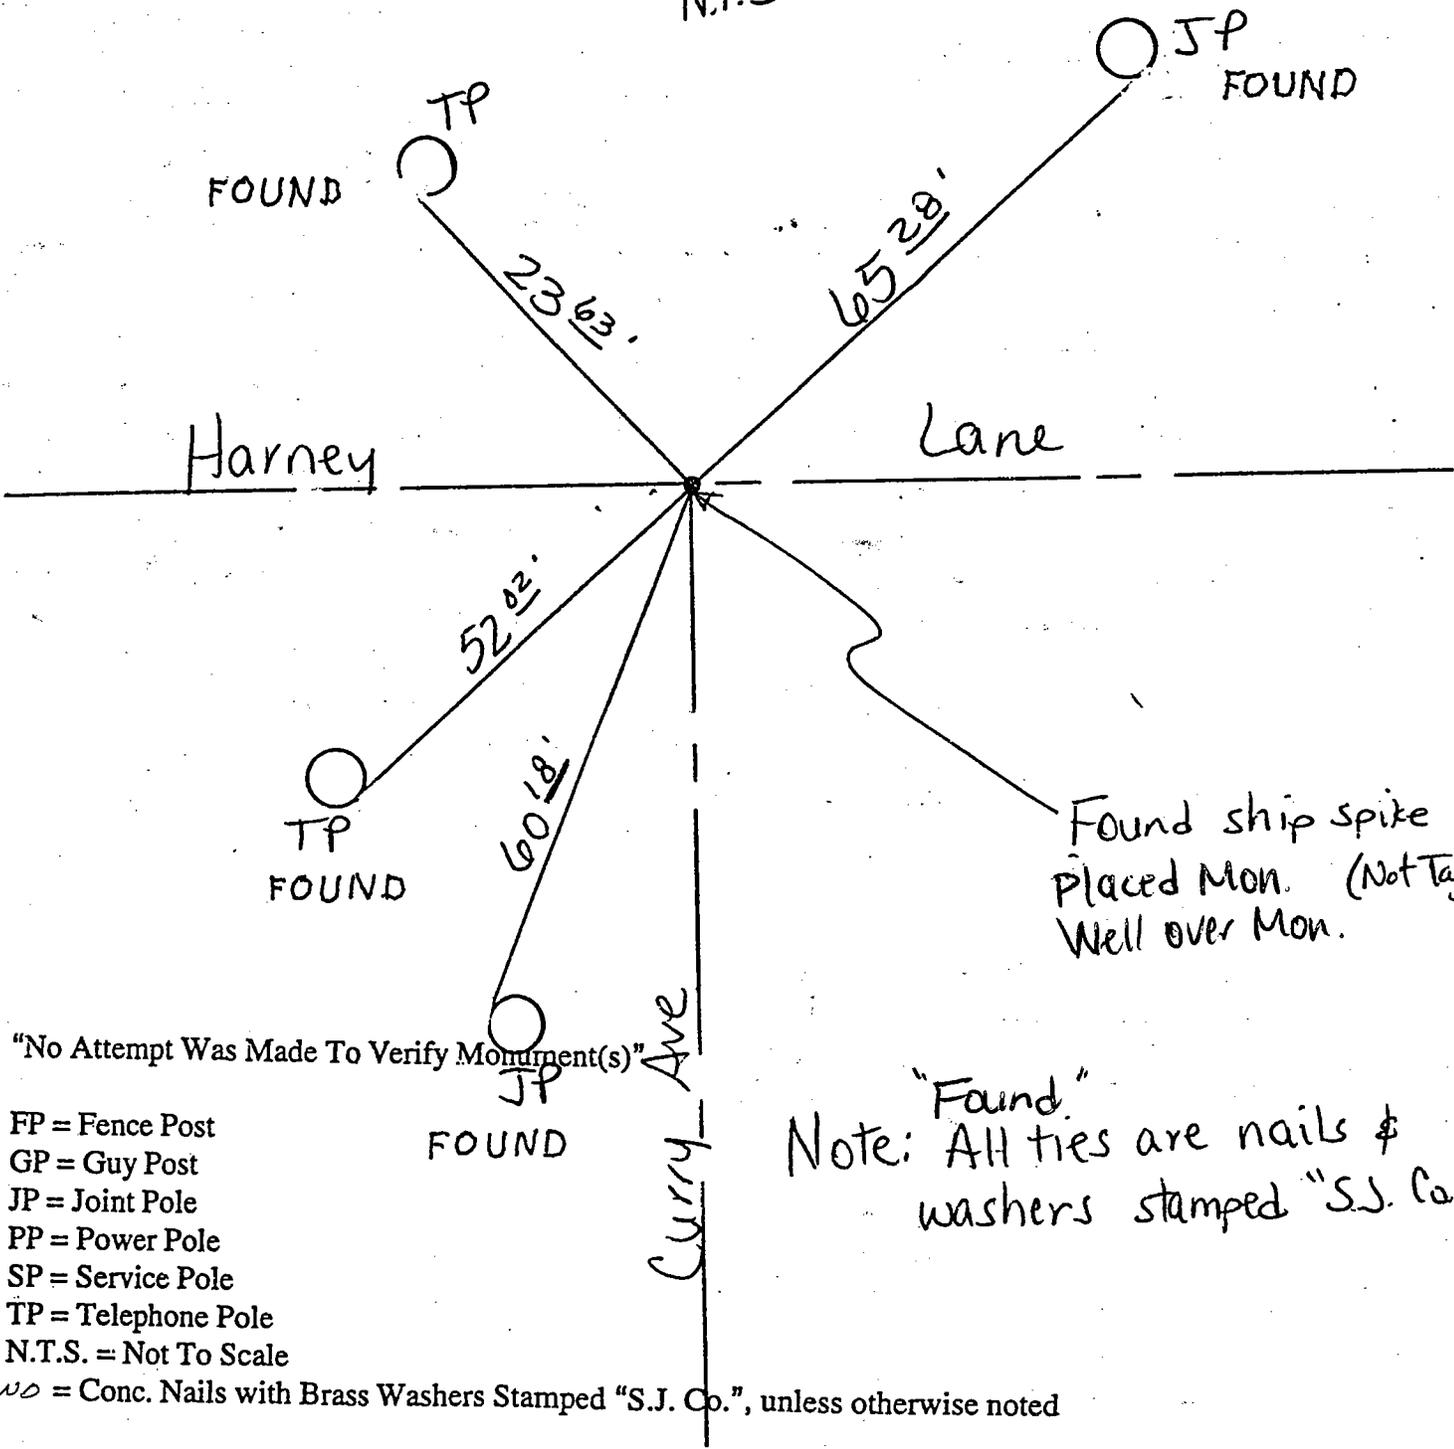

"No Attempt Was Made To Verify Monument(s)"

- FP = Fence Post
- GP = Guy Post
- JP = Joint Pole
- PP = Power Pole
- SP = Service Pole
- TP = Telephone Pole
- N.T.S. = Not To Scale

FOUND = Conc. Nails with Brass Washers Stamped "S.J. Co.", unless otherwise noted

"Found"
 Note: All ties are nails & washers stamped "S.J. Co."