

CORNER RECORD	20-120
City of	Document Number 00-130  County of San Joaquin , Californi
Brief Legal Description N/E CORNER OF THE	N/W 1/4 OF SECTION QO
T.3N., R.7E.	
CORNER TYPE	COORDINATES (Optional)
1 7 Government Corner 🗷 Control 🗆	N E
Meander □ Property □	Zone NAD27 □ NAD83 □
2 O Rancho Dother D	NAD83 Epoch Elev
Date of Survey 12-30-99	Vert. Datum: NGVD29 ☐ NAVD88 ☐
T.3 N., R.7E.	Meas. Units: Metric 🗆 Imperial 🗷
Corner - Left as found □ Found and tagged □ Establis	hed □ Reestablished Rebuilt 🄀
Identification and type of corner found: Evidence used to identify or pr	ocedure used to establish or reestablish the corner
	YD ROLT & WASHER
PER. R.S. 26-43 PER SWING TIE	• • • • • • • • • • • • • • • • • • • •
SKETCH ON BACKSIDE	·
A description of the physical condition of the monument as found and	
WASHER PER. R.S. 26-43 IN G	
PLACED A MONUMENT WELL C	OVER THE MONUMENT
SURVEYOR'S STATEMENT	
This Corner Record was prepared by me or under my direction in conformance with	
the Land Surveyors' Act of Feb 1 , 200 O. No. 23341	
Signed	
COUNTY SURVEYOR'S STATEMENT	CALIFORNIA CONTRACTOR OF CALIFORNIA CONTRACTOR
This Corner Record was received 2/5, 2000	and examined
and filed	D PROFESSION
Signed Henry M. Herata R.C.E. No.	21258
Title County Surveyor	
-	No. 21258 Exp. 9-30-01
County Surveyors Comment	CIVIL
	W. Charles
(D.D. Sheet No. 16)	
(D.D. Offeet No)	

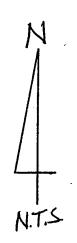

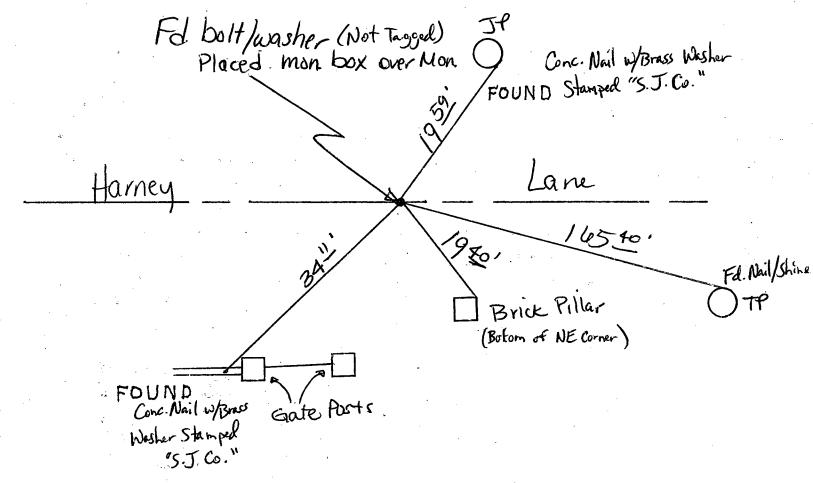

"No Attempt Was Made To Verify Monument(s)"

FP = Fence Post

GP = Guy Post

JP = Joint Pole

PP = Power Pole

SP = Service Pole

TP = Telephone Pole

N.T.S. = Not To Scale

= Conc. Nails with Brass Washers Stamped "S.J. Co.", unless otherwise noted