
CORNER RECOF	RD	Dc	ocument Numbe	er CR-	00-173
City of	· · · · · · · · · · · · · · · · · · ·				00-173 , California
Brief Legal Description	n Escalon-Bellota	Road	6622'	t north	04
Gaune Road			·		
CORNER TYPE				RDINATES (C	
		П	N		
	Government Corner ☐ Control  Meander ☐ Property  Rancho ☐ Other		Zone NAD83 Epocl	NAD27	7 □ NAD83 □
	2-12-00				NAVD88 □
	Date of Survey 3-13-00	<del></del>		Metric □	_
Corner - Left as four	nd ጆ Found and tagged □ Esta	ablished 🗆	Reestablish	ed 🗆 Reb	ouilt 🗆
Identification and type of	corner found: Evidence used to identify	or procedure	used to establi	sh or reestabl	ish the corner:
See	Sketch on Back	Side		·	
					<del></del>
				<u> </u>	
	the state of the manufacture of the state of	d and as set	or reset:		
A description of the phys	ical condition of the monument as found	and as sell	andition		
	e Sketch on Backs	ide	ond india		
	e skeller on ledges	1000			
	-			ED PR	OFESSION OF THE PROPERTY OF TH
	SURVEYOR'S STATEMENT				S RYAN
This Corner Record was	s prepared by me or under my direction i	n conforman	ice with	REG TH	
the Land Surveyors' Act	on May 24 ,20	10 <u>0</u> .			p. 23341
Signed	t <del>L.S. o</del> r R.C.E. N	1umber <u>22</u>	334		. 12-31-01
, ,	OUNTY SURVEYOR'S STATEMENT		•	OF COLOR	OF CALIFORNIA
	s received <u>MAY 25</u> , 21	00 and exa	amined	ED PRO	FESSIONA
	Y Z9 ,200 <u>0</u>			STATION OF THE PROPERTY OF THE	
and med	R.C.	:F No ZE	3054	S S S S S S S S S S S S S S S S S S S	28054
Title	County Surveyor			u 1 ,	es:3 /31 /oz/st/
True	Sounty Surveyor			Van C	WIL
County Surveyors Co	mment			T/F OF	CALIFORNIA
				<del></del>	
		<del></del>		V- 2	
	4 (	<u> </u>		<u> </u>	
(D.D. Sheet No. <u>40</u> ,	41)			·	

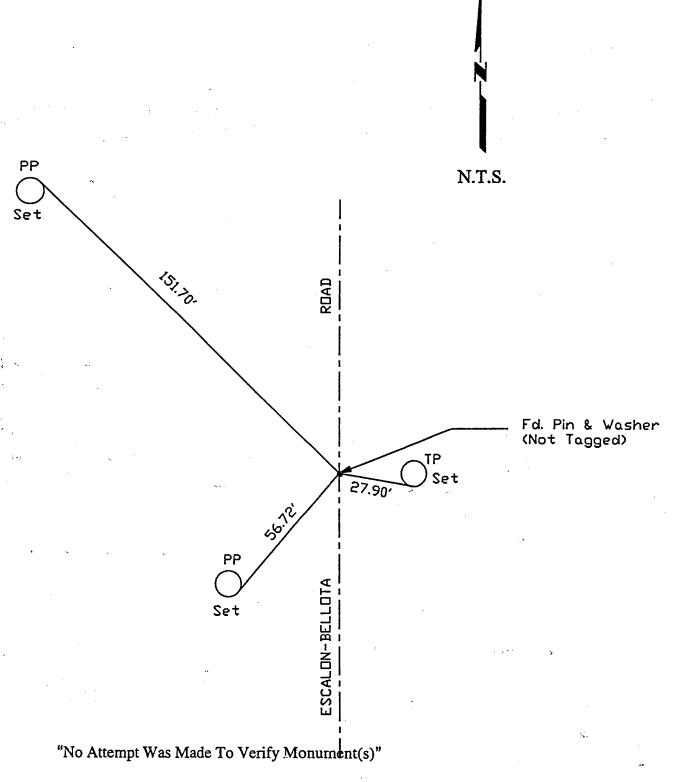

FP = Fence Post

GP = Guy Post

JP = Joint Pole

PP = Power Pole

SP = Service Pole

TP = Telephone Pole

N.T.S. = Not To Scale

Set = Conc. Nails with Brass Washers Stamped "S.J. Co.", unless otherwise noted