
CORNER RECO	ORD			Da array and Marmah an	00-204
City of				Document Number County ofSan Joaq	
Brief Legal Description	On Airont	Way -	7001±	Southwesterl	y of
French Cap	2 Road			·	
T CHOT COCK	· (	RNER TYPE			ATES (Optional)
		- Control		N E.	
	Government Corner Meander	r □ Control □ Property		Zone	NAD27 NAD83
	Rancho	☐ Other	Ø.	NAD83 Epoch Elev	
	Date of Survey	6-1-00		Vert. Datum: NG	VD29 □ NAVD88 □
				Meas. Units: Me	inc d impenar
Corner - Left as for	ound  Found and	tagged D Es	stablished	☐ Reestablished 🗡	【 Rebuilt □
Identification and type	of corner found: Eviden	ice used to identify	or proced	ure used to establish or	reestablish the corner:
Reestablish	red location	0+ Fd	TK	Mail per s	wings on
CR-00-67	See ?	Sketch o	n ba	CKS124	
					<del></del>
A	ysical condition of the r	monument as four	nd and as s	et or reset:	
Col 3/ " v	30" tron	Pin and	Placed	Mon Well	over Mon.
	RKetch on P		-1 -1 14		
			•		SOCEES ON
	SURVEYOR'S STA				SAS RYAD
This Corner Record w	as prepared by me or u	inder my direction	niotroo ni Ooo	nance with	
the Land Surveyors	eton <u>June 1</u>				No. 23341
Signed		<del>L.S.</del> or R.C.E.	Number <u>2</u>	3341	Exp. 12-31-01
	OUNTY SURVEYOR'S	S STATEMENT			OF CALIFORNIA
This Corner Record w	ras received	E 14 ,2	200 <u>0</u> and	examined	PROFESSIONA
	UNE 15				THOSE CONTRACTOR
Signed Mar	Agob lun	R.G	C.E. No	28054 B	7厘
Title	County Surveyor			<b>\</b> ,	C28054 Expires: 3/31/07#
					CNIL
County Surveyors C	omment				OF CALIFORNIA
	<u> </u>				
(D.D. Sheet No. 3	<u>)</u>				



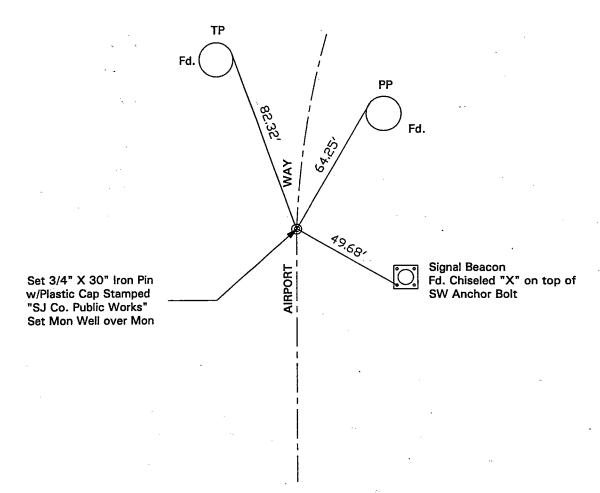

"No Attempt Was Made To Verify Monument(s)"

FP = Fence Post

GP = Guy Post

JP = Joint Pole

PP = Power Pole

SP = Service Pole

TP = Telephone Pole

N.T.S. = Not To Scale Fd = Conc. Nails with Brass Washers Stamped "S.J. Co.", unless otherwise noted