
CORNER RECO	RD		Danuma	nt Niumbar	00	-217
City of		<del></del>	County o	f <u>San J</u>	oaquin	, Californ
Brief Legal Description	NE CORNER	OF SE	QUARTE	OR OF	SE	CTION I
T3NRSE	<u> </u>					· · · · · · · · · · · · · · · · · · ·
	CORN	NER TYPE			DINATES (	-
13 N	Government Corner					
12 7 N		☐ Property □	7 7 7	3	NAD2	27 □ NAD83 □
12 1 R	Rancho	☐ Other □	7 NAD	83 Epoch_		
9 4	Date of Survey	1-71-00				NAVD88
	Date of Survey	4 21 00	—– Mea	s. Units:	Metric	Imperial 犀
Corner - Left as for	und Found and tag	ged □ Estab	lished □ Re	establishe	d □ Re	built 🗆
·						<del>.</del>
	of corner found: Evidence					
SEE S	sketch on	BACKSIDE		<u> </u>		<del></del>
	4.	<del></del>				
	9 4			····	<u> </u>	
		<del></del>				
					<del></del>	<del></del>
	rsical condition of the mon					
	JUMENT IN	•				
SEE SKET	CH ON BAC	KSME				· · · · · · · · · · · · · · · · · · ·
			<del></del>			
	· · · · · · · · · · · · · · · · · · ·				165	ROFESSIO
	SURVEYOR'S STATEM	MENT				AS BYAND
This Corner Record was	s prepared by me or unde		onformance with			
	on July U					★ Z → No. 23341
	/ — —					p. 12-31-01
Signed		L.S. or R.C.E. Num	1ber <u>233 7 1</u>		<b>PATE</b>	CIVIL OF CALIFORNIA
	OUNTY SURVEYOR'S ST					OFFSC
This Corner Record was	s received <u>JULY</u>	_ <i>6</i> ,200 <u>⊆</u>	2 and examined		RED PA	EL LO
and filedJULY	10	, 200 <u>0</u> .			18/20 X	
Signed	and Slaver	R.C.E.	No. 28059	<i>‡</i>		20054
Title	- 11					28054 res: 3/31/62
1100	Double Curveyor				Most c	CAM
County Surveyors Co	mment				TEOL	CALIFORNIA
					*,	·
		·	<del></del>			
(D.D. Sheet No. <u>86</u>	6.14.)					
12.2. 211001 140. 24 4	<del></del> /					

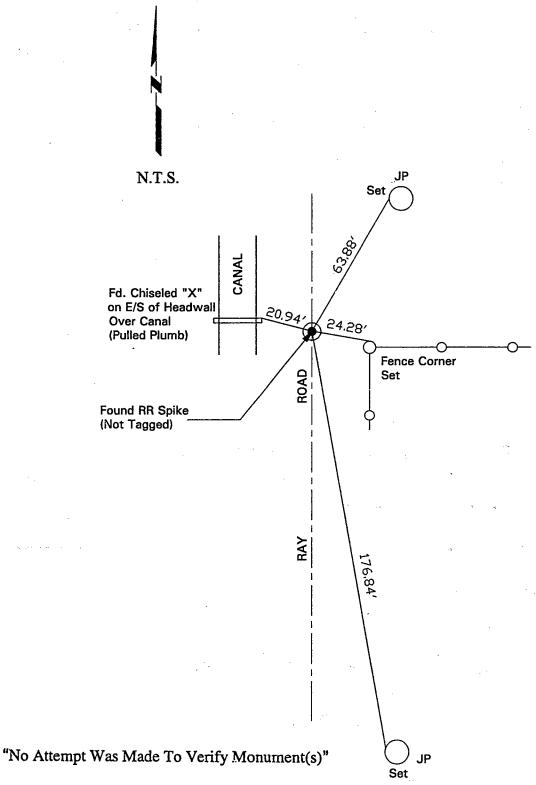

FP = Fence Post

GP = Guy Post

JP = Joint Pole

PP = Power Pole

SP = Service Pole

TP = Telephone Pole

N.T.S. = Not To Scale

Set = Conc. Nails with Brass Washers Stamped "S.J. Co.", unless otherwise noted