
CORNER RECO	RD		Document Number County of <u>San Jo</u>	00 -	Z31 California	
City of				Jaquin	Parad	
City of	Intersection	1 of Live Ug	k Koad and	1 1 UV19	Road	
	CORNER TYPE			COORDINATES (Optional) N		
	Government Corner Meander Rancho	□ Control □ □ Property □ □ Other 🗖	E Zone NAD83 Epoch_ Elev	NAD27	□ NAD83 □	
	Date of Survey	10-2-00	Vert. Datum: Meas. Units:		NAVD88 ☐ Imperial 💢	
Corner - Left as for	ınd Found and ta	agged   Establishe	d □ Reestablishe	ed Æ Reb	uilt j	
Identification and type o Reestablished CR-00-223	location of	e used to identify or proc found PK na h on backsio	11 & Shintz	h or reestablis	sh the corner:	
					· _ ·	
A description of the phy Set 3/4" X 3 See Sket	o" Iron Pintch on back:	& placed mo	n well over	mon.		
	SURVEYOR'S STAT	EMENT			PS RYAN	
This Corner Record was	as prepared by me or ur	nder my direction in confo		EX,	Vo. 23341 P. 12-31-01	
Signed		_ <del>L.S. or</del> R.C.E. Numbe	23341	SATE.	C/VIL OF CALIFORNIA	
	OUNTY SURVEYOR'S			N PRO		
This Corner Record was		<u>/ [4</u> ,200 <u>0</u> a ,200 <u>0</u> .	nd examined		1000	
Signed Man	saak lan	R.C.E. No	28054	E C2	8054	
Title				* Expire	es: 3/ 3//07/	
County Surveyors C	omment			OF OF	CALIFORNIA	
				- <del> </del>	<u> </u>	
					<u></u> i	
			<u> </u>			
(D.D. Sheet No.	6)					



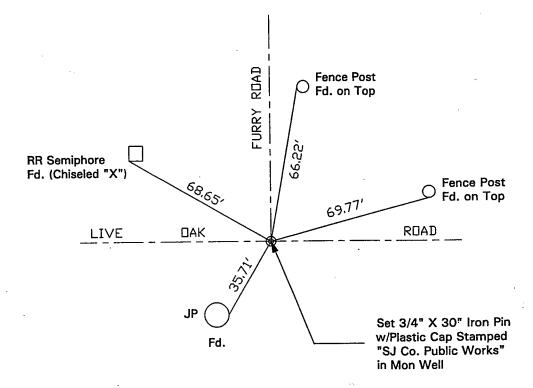

## "No Attempt Was Made To Verify Monument(s)"

FP = Fence Post

GP = Guy Post

JP = Joint Pole

PP = Power Pole

SP = Service Pole

TP = Telephone Pole

N.T.S. = Not To Scale

Fo = Conc. Nails with Brass Washers Stamped "S.J. Co.", unless otherwise noted