
CORNER RECORD			Document Number 00 - 249		
City of			ounty of	San Joaquin	, Californic
Brief Legal Descript	tion CENTER OF SECTION 16, T.2S.,R.8E.				
	O O D VIET TVOE			DINATES (Opti	ional
	CORNER TYPE				
	Government Corner 🗵 Control		N E Zone	NAD27	□ NAD83 □
1+6	Meander		NAD83 Epoch_		
.			Elev Vert. Datum:	NGVD29 □	
T.2S.,R.8E	Date of Survey <u>JULY 17, 2000</u>		Meas. Units:	Metric □	Imperial 🖾
Corner - Left o	as found 🗵 Found and tagged 🗌 🛚 Estab	olished 🗆	Reestablishe	d □ Reb	uilt 🗀
Identification and	type of corner found: Evidence used to ident	tify or proc	edure used to es	tablish or reest	ablish the corn
SEE SKETCH ON BA					
	ne physical condition of the monument as fou				
	ne physical condition of the mondifiert as foo NT IN GOOD CONDITION. SEE SKETCH ON BAC				
FOUND MONUMEN			<del></del>		
					DOFECO
	SURVEYOR'S STATEMENT				AS RYAN
This Corner Pecors	d was prepared by me or under my direction	in conform	ance with		
1110 0011101	ors Action Aug 28, 2000				* 2
	A COLOR		22241	[x] F	No. 23341 xp. 12-31-01
Signed	L.S. or R.C.E. Nu	umber	25541		NP. 12-31-01
	COUNTY SURVEYOR'S STATEMENT				E OF CALIFORNAL
This Comer Reco	ord was received <u>AUGUST Z9</u> , 20	000 and ex	kamined	PRO	FESS/O
and filed	AUGUST 30 , 2000.			W. NU	ELLO
	anul Low R.C.E	= No Z	B0<4		
Signed		140		C	28054
Title	County Surveyor			B .1	es: 3/31/07/4/
	C			M.S.C	MIL
County Surveyo	rs Comment			THE OF	CALIFORN
			<del></del>		
		<del></del>			
(D.D. Sheet No.	60				<i>.</i>



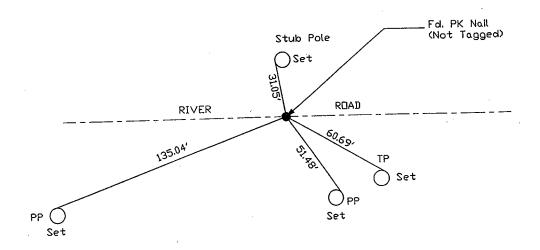

"No Attempt Was Made To Verify Monument(s)"

FP=Fence Post
GP=Guy Post
JP=Joint Pole
PP=Power Pole
SP=Service Pole
TP=Telephone Pole
N.T.S.=Not To Scale
Set=Conc. Nails with Brass Washers Stamped "S.J. Co.", unless overwise noted