
CORNER RECORD					Document Number 00-253				
City of				<del></del>				, Californic	
Brief Legal Descript	tion <u>ON RIVER ROAD 372'± E</u>	AST O	F MCHENR	Y AVENU	<u>E</u>		<del></del>	<del></del>	
			J			·	<del> </del>		
	CORNER TYPE					COORDINATES (Optional) N			
	Government Corner		Control		E		NADO7	□ NAD83 □	
	Meander		/		NAD83 Ep	och	NAD2/		
	Rancho		Other	$\boxtimes$	Elev Vert. Datu				
	Date of Survey <u>JULY</u>	17, 200	00		Meas. Unit			Imperial ⊠	
Corner - Left a	s found 🛛 Found and ta	gged	☐ Esta	blished (	☐ Reestab	lished 🗆	Rebu	ıilt 🗀	
Identification and	type of corner found: Evide	nce us	sed to ider	ntify or pro	ocedure used t	o establish	or reesto	ablish the come	
SEE SKETCH ON BAC	CKSIDE								
		····							
		<del></del>			<del></del>				
<del></del>						· · · · · · · · · · · · · · · · · · ·			
	e physical condition of the				as set or reset:_				
FOUND MONUMEN	IT IN GOOD CONDITION. SE	E SKET	CH ON BA	CKSIDE		· · · · · · · · · · · · · · · · · ·			
	SURVEYOR'S STATEM	AFNT					ED PI	OFESSION	
This Corner Record	was prepared by me or ur		v direction	in confo	rmance with		AN COLOR	S RYAN	
	ors' Act of Aug ZE		, 2000						
					23341	<b>\</b> \_2	A No	<b>*</b> Z 田 D. 23341	
Signed		L.3. 0	r R.C.E. Nu	Jmber	20041		Exp.	12-31-01	
	COUNTY SURVEYOR'S S	TATEN	<b>MENT</b>				STIFF	CALIFORNIA	
This Corner Reco	rd was received <u>AUG</u>	UST	<u> </u>	000 and	examined			ROFESSIO	
and filed	7UGUST 30	_, 200	00.					UELLO	
Signed M	sand luma		R.C.E	. No. 2	18054				
Title	County Surveyor	`		······		<b>(</b> '	<b>~</b>	C28054	
	3001117 0017070.	•				1		020054 Dires:3/3//67/4	
County Surveyors	s Comment					`		CNIL	
, = = × = <b>, =</b> ·							THE	OF CALIFORNA	
								-1	
(D.D. Sheet No.	62								



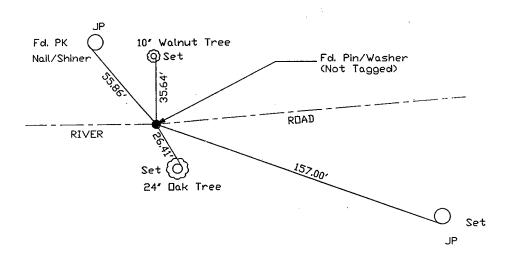

"No Attempt Was Made To Verify Monument(s)"

FP=Fence Post
GP=Guy Post
JP=Joint Pole
PP=Power Pole
SP=Service Pole
TP=Telephone Pole
N.T.S.=Not To Scale

Set=Conc. Nails with Brass Washers Stamped "S.J. Co.", unless overwise noted