
CORNER RECORD			Doo	Document Number 60-284			
City of		,	_ Cou	unty of	San Joaquin	, Californic	
Brief Legal Description ON RIVER RO	DAD 1275'± WEST	OF MCHENRY	AVENUE				
				<del></del>			
	CORNER TYPE			COORDINATES (Optional)  N  ENAD27  NAD83			
Governm	nent Corner	Control 🗆		E			
Meande		Property		Zone NAD83 Epoc	NAD2/ h	□ NAD83 □	
Rancho		Other 🖂		Elev	NGVD29 □	NAVE00 [	
Date of S	Survey <u>SEPTEMBER</u>	7, 2000	_		Metric		
Corner - Left as found ⊠ Fo	und and tagged	☐ Establish	ned 🗆	Reestablish	ed 🗌 Reb	uilt 🛛	
Identification and type of corner f	ound: Evidence I	used to identify	or proced	dure used to a	establish or reest	ablish the come	
FOUND PIN AND WASHER. CONFIR						- COME	
						· · · · · · · · · · · · · · · · · · ·	
A description of the physical cond	lition of the monu	ment as found	and as se	et or reset:		·	
FOUND MONUMENT IN GOOD CO	ndition. See ske	TCH ON BACKS	IDE				
			<del></del>				
						OFESON	
CLIDIVEVO	OR'S STATEMENT				EU MAS	S RYAN	
This Corner Record was prepared		ny direction in a	conforma	ince with			
the Land Surveyors' Agt on		-	Somonna		M. No	* 28	
				2241	Exp.	. 23341 12-31-01	
Signed	<del>L.S. c</del>	57 R.C.E. NUMI	oer <u> </u>		SATE OF	IVIL	
	RVEYOR'S STATE					CALIFORN	
This Corner Record was received			and exa	amined	ED PROFESSI		
and filed <u>9-20-</u>	, 20				EXTO 22 CO		
Signed Manual &	PAR	R.C.E. N	o. 28	3054	A REG	と記	
Title County Surv	eyor				C28054	, ,	
					Expires: 3/	51/02 <b>/36/</b>	
County Surveyors Comment	·····				CML CALIFOR	AND THE PERSON NAMED IN COLUMN TO TH	
						-	
	· · · · · · · · · · · · · · · · · · ·						
(D.D. Sheet No)					· •		



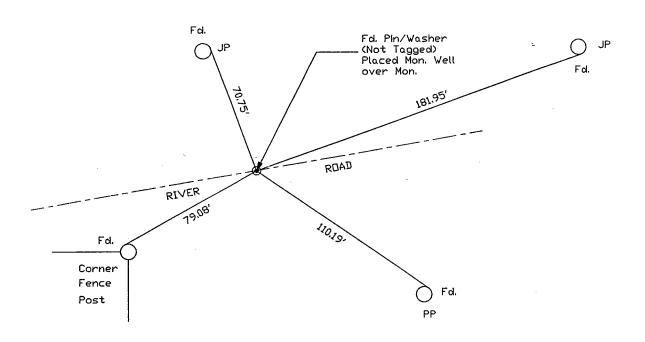

"No Attempt Was Made To Verify Monument(s)"

FP=Fence Post GP=Guy Post JP=Joint Pole PP=Power Pole SP=Service Pole TP=Telephone Pole N.T.S.=Not To Scale

Fd.=Conc. Nails with Brass Washers Stamped "S.J. Co.", unless overwise noted