
CORNER RECORD	Document Number		
City of	County of S	ian Joaquin	, Californi
Brief Legal Description <u>CENTER OF SECTION 16, T.2S.,R.8E.</u>		<del> </del>	
CODNED TYPE	-		
CORNER TYPE	N	COORDINATES (Optional) N	
Government Corner ⊠ Control □	EZone		
Meander □ Property □	NAD83 Epoch_	NAD27	□ NAD83 □
Rancho 🗆 Other 🗀	Elev		
Date of Survey SEPTEMBER 7, 2000		NGVD29	· —
T.2S.,R.8E	Meas. Units:	Metric 🗆	Imperial 🛚
Corner - Left as found 🗌 Found and tagged 🗎 Establishe	d 🗆 Reestablished	⊠ Reb	uilt []
lentification and type of corner found: Evidence used to identify of EESTABLISHED LOCATION OF FOUND PK NAIL PER SWINGS ON CR-00	1-249. SEE SKETCH ON BA	CKSIDE	ublish the come
		· · · · · · · · · · · · · · · · · · ·	
		<del></del>	
A description of the physical condition of the monument as found a	nd as set or reset:		·
SET $3/4" \times 30"$ IRON PIN AND PLACED MON. WELL OVER MON. SEE SKE	TCH ON BACKSIDE		
		<del> </del>	
SURVEYOR'S STATEMENT			AS RVAN
his Comer Record was prepared by me or under my direction in co	-f	[S]	ON CONTRACT
286	niormance with	国i	
		   Liter	No. 23341
igned <del>L.S. o</del> r R.C.E. Numbe	r23341	1.1	Exp. 12-31-01
COUNTY SURVEYOR'S STATEMENT			CIVIL OF CALIFORNIA
his Corner Record was received 9-18 - , 2000 ar	nd examined	PROF	ESSION
nd filed 9-20-, 2000.		NUE	r 70%
igned Manuel Sport R.C.E. No.	28054		
tle County Surveyor		11 .1	3054 s:3/3//02/*/
County Surveyors Comment		ST. CI	VIL
Sorry Sorreyors Confinent		OF	ALITO
			<u></u>
D.D. Sheet No. 60 )			



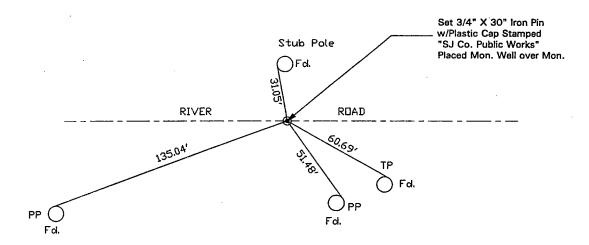

"No Attempt Was Made To Verify Monument(s)"

FP=Fence Post GP=Guy Post

JP=Joint Pole

PP=Power Pole

SP=Service Pole TP=Telephone Pole

N.T.S.=Not To Scale

Fd.=Conc. Nails with Brass Washers Stamped "S.J. Co.", unless overwise noted