
CORNER REC	CORD				Document Num	nber <u>00-</u> 2	292
City of			<u> </u>		County of	San Joaquin	, Californi
Brief Legal Description	on <u>NW CORNER OF SECT</u>	10N 5, T.3	3N.,R.8E.				*
	CORNER TYPE				COORDINATES (Optional)		
31 32	Government Corne Meander		Control Property		E Zone NAD83 Epo	NAD27	□ NAD83 □
6 5 T.3N.,R.8E	Rancho  Date of Survey <u>SEP</u>	_	Other 1, 2000		Elev Vert. Datur	n: NGVD29 🗆 : Metric 🗆	
	ound 🛭 Found and t	agged [	] Estak	olished (	Reestablis      Restablis      Reestablis      Reesta	shed □ Reb	ouilt 😭
Identification and typ	pe of comer found: Evid	ence use	ed to ident	tify or pro	ocedure used to	establish or rees	tablish the come
FOUND AXLE. CONFIR	RMED LOCATION PER SV	VINGS ON					•
A description of the c	physical condition of the	monum	ent as fou	nd and a	as set or reset.		
	N GOOD CONDITION. S				as set Of teset		
		OKLIO	011 0710	NOIDE		·	
			-				
	SURVEYOR'S STATE	ATNIT				VROFESSION S BYA	
This Corner Record wa	as prepgred by me or u		direction i	n confor	mance with	John S. M.	
the Land Surveyors'	// // ~	_	, 2000.		maneo min		至图
Signed		L.S. or F	 R.C.E. Nur	mber	23341	No. 2334: Exp. 12-31-	
	COUNTY SURVEYOR'S					STATE OF CALIFOR	
	was received <u>Nove</u>			10 and e	examined	ODEFSS	
and filed NOVE		, 2000.		o di la c	Mariniea	ARE TUEL !	-033
Signed \( \square\)	96	_		<u>-</u>	28054	\$ Z	
	County Surveyor	1	K.C.E.	NO	2003 1	C2805	· , , ,
County Surveyors C	omment			·		CNIL	
		<del></del>		<del></del>		- OAC	
(D.D. Sheet No. 9	, 18						

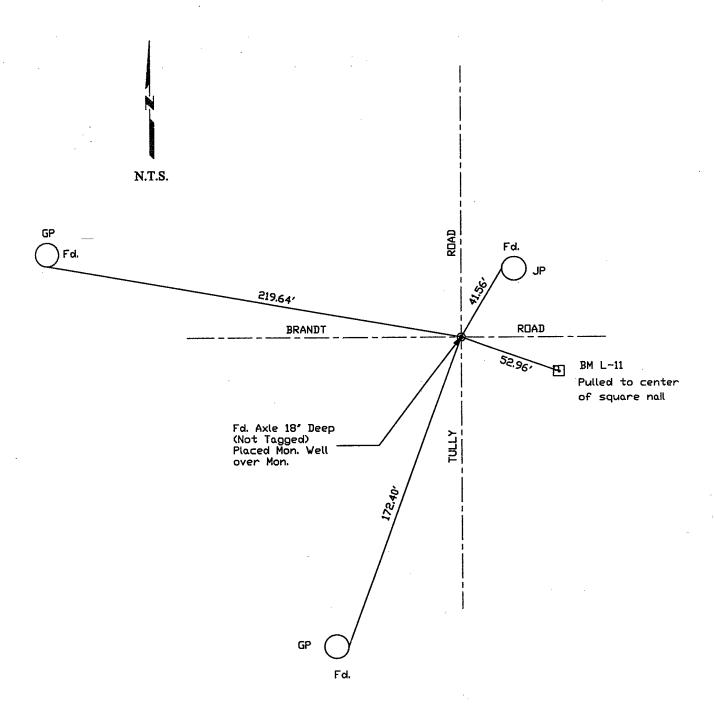

"No Attempt Was Made To Verify Monument(s)"

FP=Fence Post GP=Guy Post JP=Joint Pole PP=Power Pole SP=Service Pole TP=Telephone Pole N.T.S.=Not To Scale

Fd.=Conc. Nails with Brass Washers Stamped "S.J. Co. Pub. Works", unless overwise noted