
CORNER RECORD		Document Number 01-5		
City of		County of .	San Joaquin	, California
Brief Legal Description	1 SE CORNER OF NE QUARTER OF SECTION 19, T.3	N.,R.6E		
	CORNER TYPE	COC	ORDINATES (Opt	ional)
	CORNER III E			
	Government Corner ⊠ Control □	E	NAD27	m NAD83 m
19+20	Meander $\square$ Property $\square$	NAD83 Epoc	:h	
-   -	Rancho 🗀 Other 🗀	Elev.	NGVD29 □	
	Date of Survey NOVEMBER 30, 2000	Meas. Units:		
T.3N.,R.6E				·
Corner - Left as fo	ound 🗆 Found and tagged 🗀 Established	☐ Reestablish	ned 🖾 Reb	uilt 🛛
	<del></del>			
Identification and typ	oe of comer found: Evidence used to identify or p	procedure used to	establish or rees	tablish the com
	TAGGED). SEE SKETCH ON BACKSIDE.			
		· · · · · · · · · · · · · · · · · · ·		
			÷	
A description of the	physical condition of the monument as found an	d as set or reset:		
A describitor of the f	N AND SET NEW TIES. PLACED MONUMENT WELL C	OVER MONUMENT. S	EE SKETCH ON B	ACKSIDE
3E1 3/4 X 30 IROI 11	<del></del>			
	<u> </u>	,		
	CUDYCYODIC CTATCACAIT		S PRUL	RYA A
	SURVEYOR'S STATEMENT	. f		
	vas prepared by me or under my direction in cor	normance wiin		
the Land Surveyors	s' set (1-5-, 2001.		No. 2	23341
Signed	L.S. or R.C.E. Numbe	r23341	(°) \ Exp. 13	2-31-01
-	COLLETY CHENTYOPIS STATEMENT		12 ON	/IL
	COUNTY SURVEYOR'S STATEMENT dwas received 8, 2001 ar			
		na examinea	EO PRO	ESSIONA
and filed	Tan 11 , 2001.		ESPANOR PROPERTY.	100
Signed M	annel a son R.C.E. No.	28054		の間
Title	<del>~ / / / / / / / / / / / / / / / / / / /</del>		C2	8054
me	Cooliny solveyor		и.\	s:3/3/107#
	Commont		C for	ML /
County Surveyors	Comment		ATE OF	CALIFORNI
(D.D. Sheet No	14)			

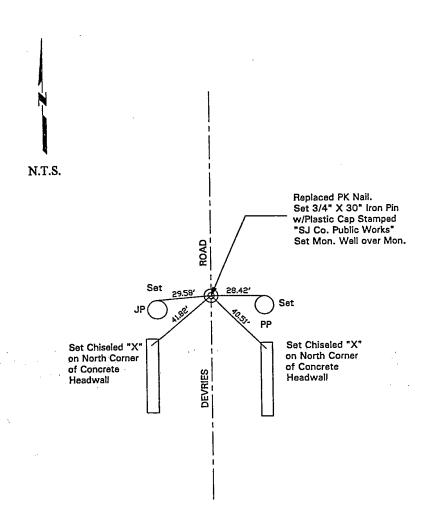

"No Attempt Was Made To Verify Monument(s)"

FP=Fence Post GP=Guy Post JP=Joint Pole PP=Power Pole SP=Service Pole TP=Telephone Pole N.T.S.=Not To Scale

Set=Conc. Nails with Brass Washers Stamped "S.J. Co.", unless overwise noted