
CORNER RECORD		Document Numb	er 01-	70
City of	<del></del>	County of		
Brief Legal Description INTERSECTION OF TRACY BOL	LEVARD AND PLATT	ROAD		
CORNER TYPE		COORDINATES (Optional)  N.  E.  ZoneNAD27  NAD83		
Government Corner	Control	E		
	Property	Zone NAD83 Epocl	NAD27 h	□ NAD83 □
Rancho	Other 🖂	Elev.		
Date of Survey NOVEMBER	27, 2000	Meas. Units:		NAVD88 □ Imperial ⊠
Corner - Left as found ⊠ Found and tagged	☐ Established	Reestablish	ed 🖂 Reb	uilt 🗀
		·	<del></del>	
Identification and type of comer found: Evidence u	sed to identify or pr	ocedure used to e	establish or reest	ablish the come
SEE SKETCH ON BACKSIDE				
			<del></del>	
			-	
A description of the physical condition of the monu		as set or reset:	·	<u> </u>
FOUND MONUMENT IN GOOD CONDITION. SEE SKE	ICH ON BACKSIDE	<del>-</del>	· · · · · · · · · · · · · · · · · · ·	
	<del></del>			
			(50 P)	GFESSION RVA
SURVEYOR®S STATEMENT				S RYAN
This Comer Record was prepared by me or under m	ny direction in confo	rmance with	E E	ZEE ZEE
the Land Surveyors Mon Feb 15				o. 23341
	 √ R.C.E. Number_2	73341		12-31-01
Signed L.S. o	TR.C.E. NUTIDEI_2	500 T1		OIVIL DE CALIFORNIA
COUNTY SURVEYOR'S STATE				ELSSOW.
This Corner Record was received		examined		DEL CONTRA
and filed, 20	01.		REG	H
Signed Manual Loss	R.C.E. No2	28054	6 6	C28054
Title County Surveyor			A CA	Dires:3/31/00/4/
County Surveyors Comment				OF CALIFORNIA
·		·		
			<del> </del>	
(D.D. Sheet No. 53 A)				

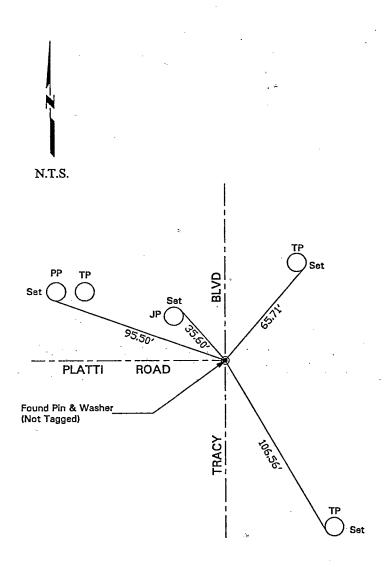

"No Attempt Was Made To Verify Monument(s)"

FP=Fence Post GP=Guy Post JP=Joint Pole PP=Power Pole SP=Service Pole TP=Telephone Pole N.T.S.=Not To Scale

Set=Conc. Nails with Brass Washers Stamped "S.J. Co.", unless overwise noted