
CORNER RECORD			cument Nu	14	
City of			ounty of	San Joaquin.	California
Brief Legal Description	on AUSTIN ROAD 1273' ± S/O LYNCH ROAD.				
B.C. to E.C. 811.83' ±					
	CORNER TYPE			OORDINATES (Op	
	Government Corner   Control		N E		
	Meander			NAD27	
	Rancho □ Other 🖾			och	
	Date of Survey <u>Dec. 20, 2001</u>		Vert, Datu	ırn: NGVD29 🗆	NAVD88 □
	Edite of 301Vey		Meas, uni	ts: Metric 🗆	I Imperial 🛛
Corner - Left as	found 🛛 Found and tagged 📋 Establish	ned 🗆	Reestab	olished [] Ret	ouilt []
	pe of comer found: Evidence used to identify				ablish the comer
SEE SKETCH ON BAC	KSIDE.				
				*	
	physical condition of the monument as found				
•	IN GOOD CONDITION. SEE SKETCH ON BACKS				
FOUND MONUMENT	IN GOOD CONDITION. SEE SKETCH ON BY COKE			<u></u>	
					*
<u> </u>		· · · · · ·			
	survéyor's statement			PROFESS	ONAL
This Corner Record	was prepared by me or under my direction in a	conform	ance with	THE STATE SO	
	s' Act on Merch 10 2005			No. C3089	
Signed Men	R.C.E. Number C	20000		E 3/31/200	ne [\frac{\pi}{2}]
Signed //////	R.C.E. Number C.	30890		STATE OF CAL	ORNIA
	COUNTY SURVEYOR'S STATEMENT	٠		OF CAL	.40
This Corner Record	d was received <u>MARCH 14</u> , 200 <b>5</b>	and exc	amined		
and filed	ANCH 14 .2005				
Signed	P.L.S. No	. 4440		ONAL	LAND
Title Assistant Co		•		(55) CF [	). LUS
Title	Sonny Son Cycl			12/4	多包
County Surgerior	Commont			51 <del></del> L	4440 의
County Surveyor's THIS CORNER RECO	RD IS NOT IN COMPLIANCE WITH BOARD RULE	164(c)	<del></del>	€x <sub>1</sub> 9-30-	pires
	TAL WITHIN 90 DAYS FROM THE DATE OF SURVE		<del></del>	1 3-20-	
	<u> </u>		<del></del>	ATE OF	CALIFORNI
	<u> </u>			UF	CALIFOR

(D.D. Sheet No. 46 )



N.T.S.

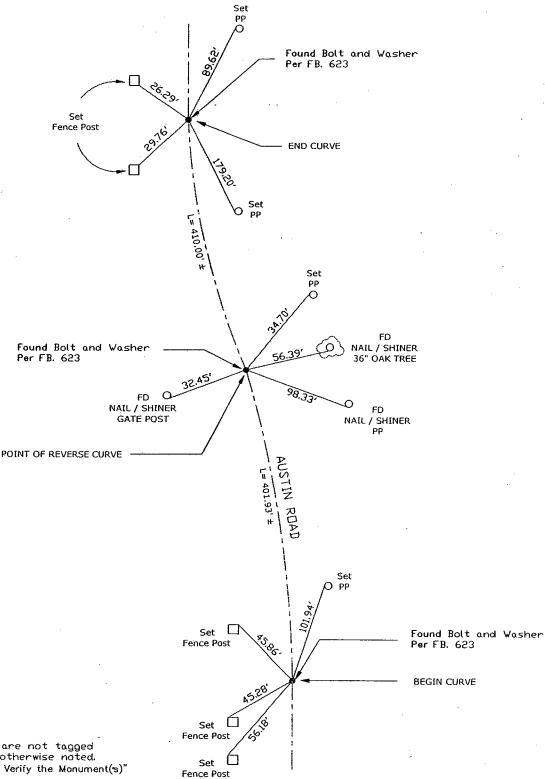

Note: Found Monuments are not tagged nor of Record, unless otherwise noted. "No Attempt Was Made to Verify the Monument(s)"

NTS= Not to Scale
FP=Fence Post
CP=Guy Post
JP=Joint Pole
PP=Power Pole
SP=Service Pole
TP=Telephone Pole
N.T.S.=Not To Scale
Set=Conc. Nail with Brass Washer Stamped
"S.J. Co.", unless otherwise noted