
CORNER RECORD				ent Numbé	(F. 07-50	
City of				of	San Joaquin,	California
Brief Legal Description	HILDRETH LANE AT RATTO	O ROAD.				
			COORDINATES (Optional)			
	CORN	N				
	Government Corner	□ Control □	E			
	Meander	□ Property □				□ NAD83 □
	Rancho	☐ Other 🛛	Elev	/		
	Date of Survey <u>Aug</u>	just 6, 2007	Ver	t. Datum:	NGVD29 ☐ Metric ☐	
Corner - Left as fo	ound 🛛 Found and tag	ged 🔲 Establish	ned 🗆 Re	eestablishe	ed 🔲 Reb	uilt 🔲
				<del></del>	·	
Identification and typ	e of corner found: Eviden	ce used to identify	or procedure	used to es	tablish or reesto	ablish the corne
SEE SKETCH ON BACK	SIDE.					
	<u> </u>					-
· · · · · · · · · · · · · · · · · · ·						
A description of the p	hysical condition of the m	onument as found	and as set or r	eset:		
	GOOD CONDITION, SEE					
					ORFE	\$810
	SURVEYOR'S STATEME	ENT			CD PHOTEL	SSIONAL S
This Corner Record wo	as prepared by me or und	ler my direction in c	onformance v	vith	AND ARRUEL	
	Act on 167. 27					30890
					HE Expores	3)31/08/2
Signed Manuel	Delocio R	.C.E. Number <u>C3</u>	0890		S. C	IVIL ONE
	COLLNITY CHONEVADIC CT	ATENAENIT			ATEOF	CALIFORNI
<b>*</b>	COUNTY SURVEYOR'S STA	4		_	17034	THE LOOK
	was received <u>DECE</u>	•	and examine	d ·		
and filed $\mathcal{DEC}$	EMBER 4	, 200 <b>.7</b> .			ONAL	LAND
Sign and Sign	M Kund	P.L.S. No	4440		(5)	D. L
Signed	) with	P.L.S. NO	4440	<del></del>	12/4	2/6
Title <u>Assistant Cou</u>	nty Surveyor	•			8 5 No	). 4440 OR
					(1 )	xpires
County Surveyor's C	omment				11 1	- 09
					100	
					ATE OF	COLLEGEN
					U	CALIFO

(D.D. Sheet No. 27 )

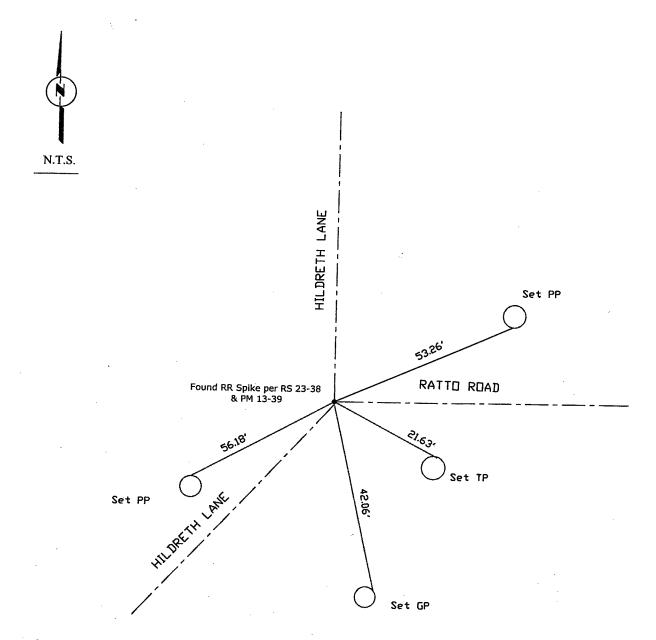

Note: Found Monuments are not tagged unless otherwise noted.

"No Attempt Was Made to Verify the Monument(s)"

FP=Fence Post
GP=Guy Post
JP=Joint Pole
PP=Power Pole
SP=Service Pole
TP=Telephone Pole
S.F.N=Searched Found Nothing
N.T.S.=Not To Scale
Set=Conc. Noil with Brass Washer Stamped
"S.J. Co.", unless otherwise noted

Note: Set Ties are Brass Washers Stamped "S.J.Co. PUBLIC WORKS"