
CORNER RECORD				Document Nur	mber CR	CR-07-65	
City of				County of	San Joaq		
Brief Legal Description	COLLIER ROAD @ CHEROK	CEE LANE.					
			·				
	CORNER TYPE			COORDINATES (Optional) N			
	Government Corner E	Control		F			
	Meander [	Property		Zone NAD83 Fpc	N/	AD27 □ NAD83 □	
	Rancho E	] Other	×	Elev			
	Date of Survey <u>May 2</u>	24, 2007	<del></del>		m: NGVD2 <sup>6</sup> s: Mefric		
Corner - Left as fo	ound 🛛 Found and tagge	ed 🔲 Esta	blished [	☐ Reestabl	ished 🔲	Rebuilt	
Identification and typ	e of corner found: Evidence	e used to iden	ntify or pro	cedure used to	establish or i	reestablish the corn	
SEE SKETCH ON BACK	SIDE.						
<u> </u>		···········					
					······································		
			<del></del>				
•	hysical condition of the mor	nument as fou	und and a	s set or reset:			
SEE SKETCH ON BAC	KSIDE.				<del></del>	- · · · · · · · · · · · · · · · · · · ·	
					<del> </del>		
	SURVEYOR'S STATEMEN	IŦ			//09	MOLESSION AL	
This Corner Record we	as prepared by me or under	r my direction	in confor	mance with	ISTERNI MACHINE		
the Land Surveyors'	Action Dec. 20	, 200_	?			No. C30890	
Signed Manuel	Mari R.C	C.E. Number_	C30890		/ <b>/</b> ★//	(pires 3/31/08) = 5	
					10 TA	TE OF CALIFORNIA	
	COUNTY SURVEYOR'S STAT		۰ <i>۲</i>		A)	Vand Mais	
and filed <u>Dec</u>	was received <u>Decem</u>	<del>ber 26</del> , 20 200 <u>7</u> .	u <b>∕</b> ana e	xaminea		Chu ( Form	
and filed	In a O	200 <u>1</u> .					
Signed	18 Thus	P.L.S.	No. <u>444</u>	10		MALLANOS	
Title Assistant Cou	nty Surveyor	•			15/1	EF D. LUZZ	
					180/2 5	No. 4440	
County Surveyor's C	Comment RD IS NOT IN COMPLIANCE V	VITH RAAPA DI	III E 161/0\			Expires	
	TAL WITHIN 90 DAYS FROM TH				\\ <b>*</b> \	9-30-09	
REGARDING SUDMIT	THE THIRT TO DATE TROOM IT		15741.			E OF THE ORINE	
					1	OF CALIFORNIA	

(D.D. Sheet No. 11 )

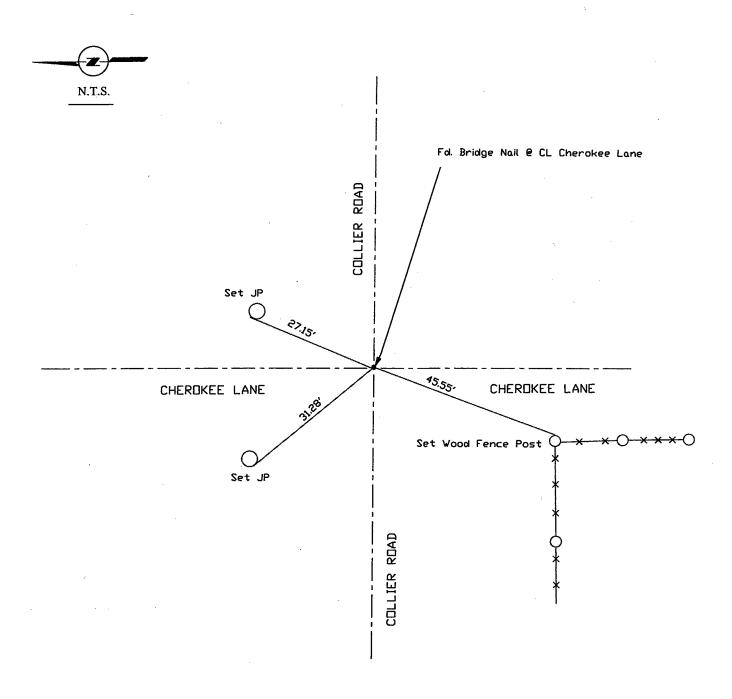

Note: Found Monuments are not tagged unless otherwise noted.

"No Attempt Was Made to Verify the Monument(s)"

FP=Fence Post
GP=Guy Post
JP=Joint Pole
PP=Power Pole
SP=Service Pole
TP=Telephone Pole
S.F.N=Searched Found Nothing
N.T.S.=Not To Scale
Set=Conc. Nail with Brass Washer Stamped
"S.J. Co.", unless otherwise noted

Note: Set Ties are Brass Washers Stamped "S.J.Co. PUBLIC WORKS"