
City of					Document Number CR-08-15				
			· · · · · · · · · · · · · · · · · · ·			ounty of		aquin,	California
Brief Legal Description	n <u>East Main Street @ Dei</u>	L MAR	RAVENUE				·		
	CORNER TYPE					COORDINATES (Optional)			
	Government Corner		Control			N			
	Meander Rancho		Property Other			Zone NAD83 Ep	och	_ NAD27 	□ NAD83 □
	Date of Survey <u>Jun</u>					Vert. Datu	ım: NGV ts: Metr	'D29 🔲	NAVD88 ☐ Imperial 🏻
Corner - Left as fo	ound 🛛 Found and tag	ged	☐ Esta	blished		Reestab	lished 🔲	Rebi	ıllt 🔲
Identification and two	e of corner found: Evider	00011	ed to iden	tify or n	roce:	dure used to		or reesto	ablish the corner
SEE SKETCH ON BACKS						uore 03ea 1			
······································	<u> </u>								
				<del>, , , , , , , , , , , , , , , , , , , </del>					
**************************************		<del></del>			<del></del>	<u>, , ,</u>			
	hysical condition of the m	nonun	nent as fou	ind and	as se	et or reset:_			·
SEE SKETCH ON BACKS	SIDE.		<del> </del>	<del></del>			<u>.</u>		
			· · · · · · · · · · · · · · · · · · ·		<del></del>				
									· · · · · · · · · · · · · · · · · · ·
				···········					
	SURVEYOR'S STATEMI	ENIT						ROFESS	ONA
This Corner Pecard wa	as prepared by me or und		y direction	in conf	orma	nce with		WHOEL GO	ALCE!
the Land Surveyors'		JOI III	, 2008.		Jima	ince wiiii	EEIS7	No. C308	90. / 清
	. 1 / .		<u>_</u> ,			•		upites 3	= 00 is
Signed Manue	<i>l bicolius</i> F	R.C.E.	. Number_	C30890	)	_	(S)	ATE OF CAL	FORMIT
C	COUNTY SURVEYOR'S ST	ATEM	MENT					OF UK	Marie
This Corner Record v	was received <u>JANUA</u>	WY.	<i>17</i> , 200	08 and	exa	mined	77.	wnoc	1000
and filed JAN	* *	, 200					. •		
ianad .	THE ALL	ارره		No. 4	440			ONALL	AND
Signed(	nty Surveyor	-	P.L.S.	NO. <u>4</u>	440			EF D.	LUSS
IIIe Assistant Cool	Try Solveyor						JOE T	<b>(</b> ()	る国
County Companies C	ommont						PA	No. 4	1 · 11
County Surveyor's Co	omment D IS NOT IN COMPLIANCE	= WITL	I BOARD PI	]] F 4611	(C)	·	/_/	Expir <b>9-30</b> - 4	, ,,
	AL WITHIN 90 DAYS FROM			·	<u>~ </u>		100	_	
TO TO TO SOLITION TO	AL MINITODATORIOM					· ·		TE OF C	ALIFORNI

(D.D. Sheet No. 32C)

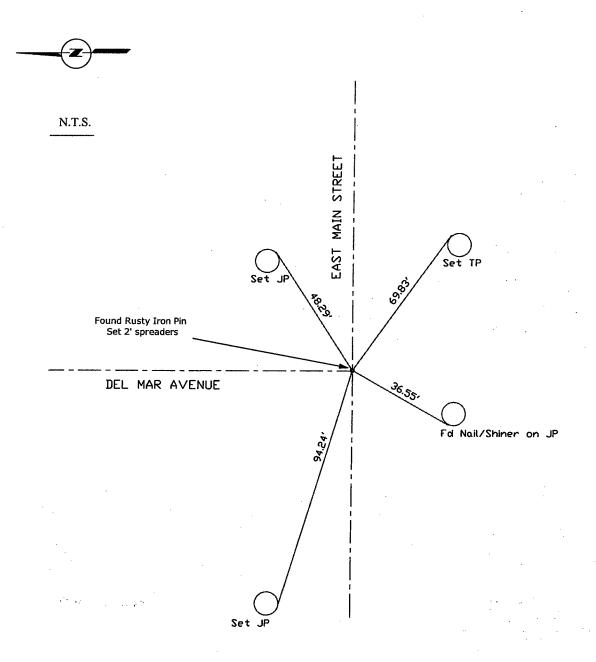

Note: Found Monuments are not tagged unless otherwise noted.

"No Attempt Was Made to Verify the Monument(s)"

FP=Fence Post
GP=Guy Post
JP=Joint Pole
PP=Power Pole
SP=Service Pole
TP=Telephone Pole
SF.N=Searched Found Nothing
N.T.S.=Not To Scale
Set=Conc. Nail with Brass Washer Stamped
"S.J. Co.", unless otherwise noted

Note: Set Ties are Brass Washers Stamped "S.J.Co. PUBLIC WORKS"