
CORNER RECORD				Document Number CR · 08 - 16			
City of			C	ounty of			
Brief Legal Description	EAST MAIN STREET @ '	WALKER LANE					
	CORNER TYPE			COORDINATES (Optional)			
	Government Corn	ner 🗆 Control		N, E.			
	Meander	□ Property		Zone	NAD27	□ NAD83 □	
	Rancho	☐ Other	<u></u> ⊠	NAD83 Ep	och		
	Date of Survey	June 29, 2005	nonemora.	Vert. Datu	im: NGVD29 🗆 is: Metric 🗆	ŅAVD88 □	
Corner - Left as fo	ound 🛛 Found and t			•	lished 🗌 Rebu		
Identification and type	e of corner found: Evid	dence used to ident			establish or reesto	ablish the come	
SEE SKETCH ON BACKS	NID E						
	·						
A description of the pl	hysical condition of the SIDE.	e monument as fou		et or reset:			
· · · · · · · · · · · · · · · · · · ·		and the second s		······································	<del></del>		
	,						
	SURVEYOR'S STATE	AAENIT	•	·	QROFESSION		
This Corner Record wa	is prepared by me or u		n conforma	unco with	THE SHOPE SOLORIE		
the Land Surveyors' A		, 2008.	n comonne	IIICE WIIII	No. C30890	1	
	1).				E Espices 3/21/0		
Signed <i>Manul</i>	2848 110	_ R.C.E. Number_	C30890	_	GIATE OF CALIFOR	ALP TO THE REAL PROPERTY.	
. C	OUNTY SURVEYOR'S	STATEMENT			OF CALL		
This Corner Record w	vas received <u>TAN</u>	WARY 17,200	8 and exa	mined	Menus 200		
and filed		, 2008.					
Signed	1-39	Ven Joseph	do 1440		11 14		
-	oty Suprovor	P.L.S. I	No. <u>4440</u>		GIONAL LA	08	
Title <u>Assistant Coun</u>	ily surveyor				150/44 D. 1	42	
David (			-		No. 444	0 5 5	
County Surveyor's Co		CE WITH BOARD BU	IF 47.41-1		No. 444 Expires		
	O IS NOT IN COMPLIANT AL WITHIN 90 DAYS FRO	··	<del></del>		9-30- <u>09</u>		
VEQUING SUDMITTA	VE AAITURIA AO DIA 12 LKO	IN THE DATE OF SUR	VET.	<del></del>	No.		
					W/F	50B/X	

(D.D. Sheet No. 32C)

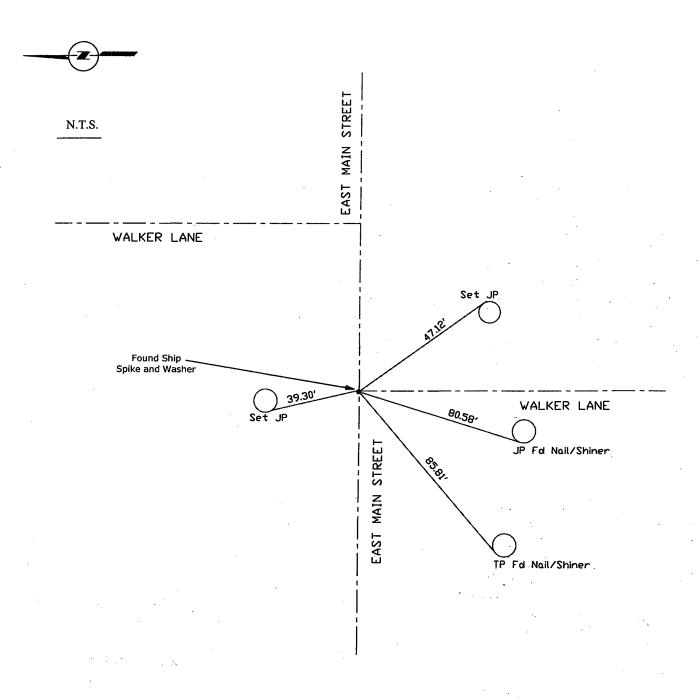

Note: Found Monuments are not tagged unless otherwise noted.

"No Attempt Was Made to Verify the Monument(s)"

FP=Fence Post
GP=Guy Post
JP=Joint Pole
PP=Power Pole
SP=Service Pole
TP=Telephone Pole
S.F.N=Searched Found Nothing
N.T.S.=Not To Scale
Set=Conc. Nail with Brass Washer Stamped
"S.J. Co.", unless otherwise noted

Note: Set Ties are Brass Washers Stamped "S.J.Co. PUBLIC WORKS"