
CORNER RECORD		` Do	Document Number <u>CR-08-24</u>			
City of			ounty of	San Joaquin,	California	
Brief Legal Description	TRETHEWAY ROAD @ WEIGUM STREET		- 75-1111 MITTE VIMAN-1-18-18-1-1 11-18-1-1-1-1-1			
		····				
	CORNER TYPE		COORDINATES (Optional) N			
	Government Corner C Control C  Meander C Property C  Rancho C Other S	]	Zone NAD83 Ep	NAD27	□ NAD83 □	
	Date of Survey <u>June 21, 2005</u>	_	Vert. Datu	um: NGVD29 🗆 ts: Metric 🗆	NAVD88 □ Imperial 🏻	
Corner - Left as for	und 🛛 Found and tagged 🗌 Establis	hed 🔲	Reestab	olished 🗆 Reb	uilt 🗆	
A description of the ph SEE SKETCH ON BACKSI	ysical condition of the monument as found DE.					
the Land Surveyors' A Signed <u>Manu</u> l Co	R.C.E. Number C3  OUNTY SURVEYOR'S STATEMENT	0890	<del>-</del> `,	No. C3089  No. C3089  Expres 3/2  OF CIVIL	¥/05∑	
and filed	WARY 18 2008.	and exar	nined	IONALLA	MO	
Signed	P.L.S. No.	. 4440		0 No. 44	40 EXPLEXA	
	IS NOT IN COMPLIANCE WITH BOARD RULE			Expire 9-30- ∠	s   ~	
REGARDING SUBMITTAI	L WITHIN 90 DAYS FROM THE DATE OF SURVE	Y.	<del> </del>	ATE OF CA	LIFORNI	

(D.D. Sheet No. -17 )

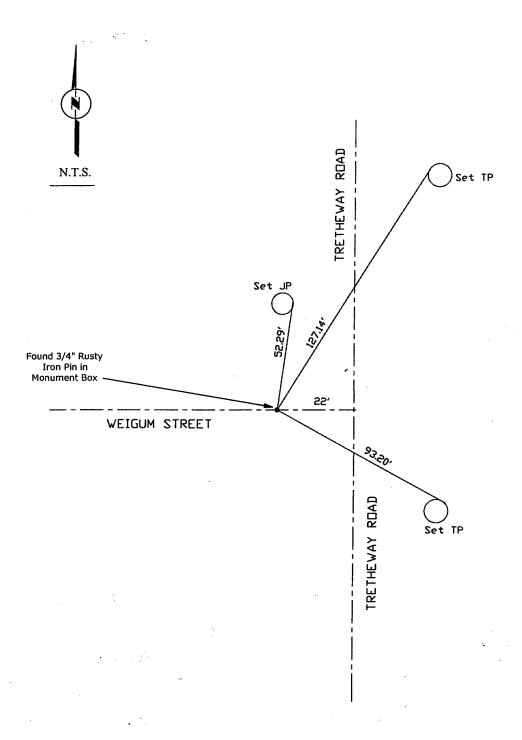

Note: Found Monuments are not tagged unless otherwise noted.

"No Attempt Was Made to Verify the Monument(s)"

FP=Fence Post
GP=Guy Post
JP=Joint Pole
PP=Power Pole
SP=Service Pole
TP=Telephone Pole
S.F.N=Searched Found Nothing
N.T.S.=Not To Scale
Set=Conc. Nail with Brass Washer Stamped
"S.J. Co.", unless otherwise noted

Note: Set Ties are Brass Washers Stamped "S.J.Co. PUBLIC WORKS"