
## CORNER RECORD

		Document I	Number
City of <u>RIPON</u>		County of _	SAN JOAQUIN , California
Brief Legal Description	SITUATE IN THE SOUTHW	EST QUARTER (	OF SECTION 19. TOWNSHIP 2
<u>SOUTH, RANGE 8 EA</u>	<u>ST, MOUNT DIABLO BASE</u>	<u>AND MERIDIAN.</u>	
	CORNER TYP	PE .	COORDINATES (Optional)
	Comment Course -		N
	<del></del>	ntrol	E
		operty 🗍	ZoneNAD27 NAD83
• /		,e, M	NAD83 Epoch Elevation
<u> </u>	Date of Survey JUNE 2	28. <i>2007</i>	Vert. Datum: NVGD29 NVGD88
	<del></del>		Meas Units: Metric   Imperial
Corner- Left as found	Found and lagged	Established	
	·		
FOLIND 3/A" IDON DI	rner lound:Evidence used to iden DE TACCEN "LC 7707"	itify or procedure us	sed to establish or reestablish the corner.
TONE POAD AND UAD	VECT DRIVE DED MADE	IN CONCRETE,	AT THE INTERSECTION OF JACK
TONE KUAD AND HAR	VEST DRIVE, PER MAPS &	& PLAIS, VOLUM	ME 31, PAGE 20, S.J.C.R.
			-
A description of the physical	condition of the monument as	found and as set o	e encolo
FOUND 3/4" IRON PIL	PE TAGGED "L.S. 3383".	IN CONCRETE.	PER MAPS & PLATS, VOLUME 31,
			M ON PAGE 2 OF 2 HERON.
		0 510.11.11	a or the 2 or 2 heron.
	SURVEYOR'S STATEMENT	•	SECONOMICONOMICO
This Corner Record was prepa	red by me or under my directio		SPE W. SPE
the Land Surveyors' Act on _	DECEMBER 5,	<u>2007</u> ,	70 ★ SVD 10 31 00 ★ SVD
- X////_		10.040	EXP. 12-31-08
Signed July 1997	P.L.S. or R.C.E.	Number LS 640	<del></del> なからの 640 でき
			MONOMORPHISES
C	OUNTY SURVEYOR'S STATE	MENT	WOODOWN THE STATE OF THE STATE
his Comes Count was and			
nis Comer Record was receive	ed,	and	examined
and filed			
igned	P.L.S. or R.C.E	. Number	
			<del></del>
	<del></del>		
ounty surveyors comment			
ORPELS -1297	Page 1 of 2		D.D. SUEET No. 60

D.D. SHEET No. 60

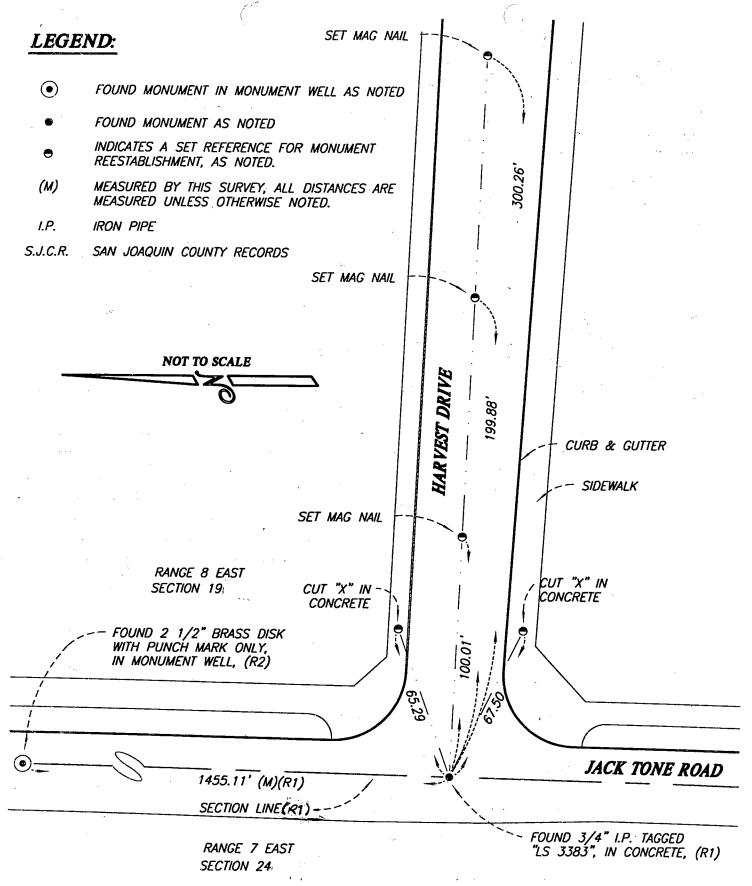

## REFERENCES:

- (R1) RECORD PER BOOK 31 OF MAPS AND PLATS, AT PAGE 20, S.J.C.R.
- (R2) RECORD PER BOOK 35 OF SURVEYS, AT PAGE 196, S.J.C.R.