
CORNER RECORD				Document Number CR 08-61		
City of	no.			County of	San Joaquin,	California
Brief Legal Description	AUSTIN ROAD SW COP	rner section	l 14			
	CORNER TYPE			COORDINATES (Optional)		
15 14	Government Corner			N E.		
	Meander	☐ Propert		Zone	NAD27	□ NAD83 □
00 00	Rancho	☐ Other	, <u> </u>		och	
22   23				Vert. Datu	ım: NGVD29 🗆	NAVD88
T2S R7E	Date of Survey <u>Mar</u>	ch 8, 2004	<del></del>	Meas. Uni	ts: Metric 🗆	Imperial 🛛
Corner - Left as fo	ound 🛛 Found and tage	ged 🔲 Est	ablished	☐ Reestab	lished 🔲 Rebu	ilt 🗀
Identification and typ	e of corner found: Evidenc	ce used to ide	entify or pr	rocedure used to	establish or reesta	hlish the corner
SEE SKETCH ON BACK		cc 0300 10 100	ormry Or pr	occuore asca r	o carabilari or recara	DIBIT THE COTTE
				· · · · · · · · · · · · · · · · · · ·		
			,	······································		
		······································	<del></del>			
,	hysical condition of the ma	onument as fo	ound and	as set or reset:		
SEE SKETCH ON BACK	SIDE.					
						· · · · · · · · · · · · · · · · · · ·
					· · · · · · · · · · · · · · · · · · ·	
			<del></del>		· · · · · · · · · · · · · · · · · · ·	
	SURVEYOR'S STATEME	NT			QROFESS/O	
This Corner Record wo	as prepared by me or und	er my directio	n in confo	ormance with	EL RIVEL SOLO	
the Land Surveyors'	Action, Fcb. 4	, 200	8.		No. C30890	
Signed Manuel	, , , ,	.C.E. Numbe	r C20000		Expires 3/31/0	ווישו
signed //Complete	R BOOTE R	.C.E. NUMBE	1_C30890	<u></u>	Or CIVIL	CHIP
(	COUNTY SURVEYOR'S STA	ATEMENT			THE OF CALIFO	
This Corner Record	was received <i>FEB</i>	. <b>5</b> ; 2	008 and	examined	Manual	Spir
and filed FE	BRUARY 7	2008			MOTHER DE	Get 6
6:	THE SHARE		· >1 4	4.40		
Signed	My June	P.L.S	S. No. <u>4</u>	440	CONALLA	NOS
Title Assistant Cou	nty Surveyor				ESTER D.	400
					00/4	6
County Surveyor's C					No. 44	1,0011
	RD IS NOT IN COMPLIANCE			c)	Expire 9-30- 6	
REGARDING SUBMITT	AL WITHIN 90 DAYS FROM	THE DATE OF S	URVEY.		3-50- <u>5</u>	
					ATE OF S	LIFORM

(D.D. Sheet No. 59

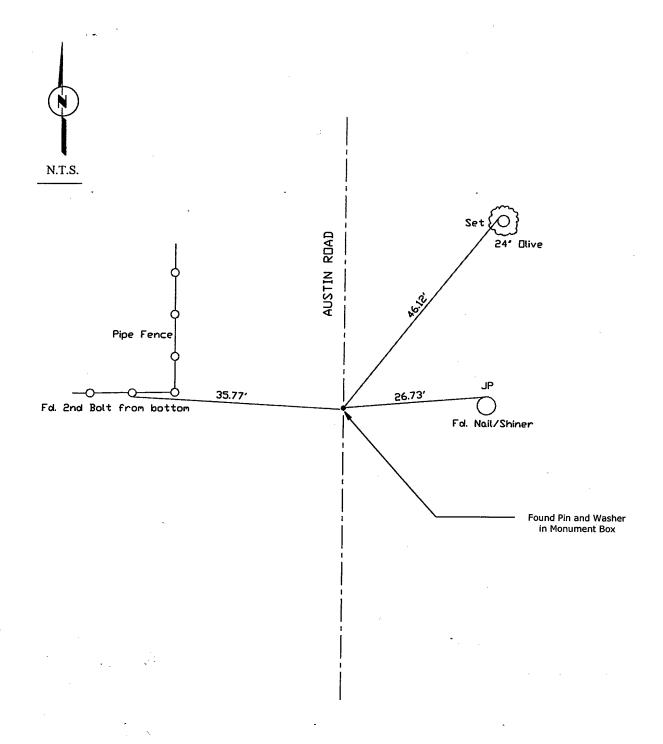

Note: Found Monuments are not tagged unless otherwise noted.

"No Attempt Was Made to Verify the Monument(s)"

FP=Fence Post
GP=Guy Post
JP=Joint Pole
PP=Power Pole
SP=Service Pole
TP=Telephone Pole
S.F.N=Searched Found Nothing
N.T.S.=Not To Scale
Set=Conc. Nail with Brass Washer Stamped
"S.J. Co.", unless otherwise nated

Note: Set Ties are Brass Washers Stamped "S.J.Co. PUBLIC WORKS"