
CORNER RECORD  City of				D	Document Number CR. 08.66		
				C	County of	San Joaquin,	. Californic
Brief Legal Description	ST JOHN AVENUE	613'+/- NC	ORTH OF NAI	RCISSUS WA	.Υ		
	CORNER TYPE				COORDINATES (Optional)		
	Government Co	orner 🗆	Control		E		
	Meander			-	Zone	NAD2	7 🗆 NAD83 🗆
	Rancho	, 🗖	Other	$\boxtimes$	Elev	······································	
	Date of Survey _	July 12, 2	2005	***************************************	Vert. Datu	m: NGVD29 E s: Metric E	,
Corner - Left as fo	ound 🛛 Found an	d tagged	☐ Estak	olished 🔲	Reestab	lished 🔲 Re	built []
Identification and typ	e of corner found: E	vidence u	sed to ident	ify or proce	edure used to	establish or rees	tablish the corner
SEE SKETCH ON BACK	SIDE.			<del></del>			
	· · · · · · · · · · · · · · · · · · ·						
		······································					
V	/			<del>v.</del>			
A description of the p		the monur	nent as four	nd and as s	et or reset:		
SEE SKETCH ON BACK	SIDE.						
	×						
			<u>.</u>			······································	<del>*************************************</del>
<del></del>				<del></del>			·
	SURVEYOR'S STA	TELAENIT				PROFESSIONS	
This Corner Record wo			v direction i	n conforma	ance with	THE SOLOR	
the Land Surveyors'	<b>.</b>		, 2008.	ii comonii		No. C30890	MEINE
	. 1 /				//	Expires 3/21/03	2 <u>5</u>
Signed Manua	BUSTIU	R.C.E.	. Number_	C30890	. <b>\</b>	STATE CIVIL	
(	COUNTY SURVEYOR	R'S STATEN	MENT			OF CALIFORN	11.
This Corner Record	was received <b>/</b>	EB. E	<b>3</b> , 200	8 and exc	mined	Manuela	Blovi
and filed FEB	RUAPY 11	, 200	8. ·			•	
Signed	W W	we	, P.I.S. N	No. 4440		NAL LA	NO.
Title Assistant Cou	nty Surveyor					SS/LE D.	
						(E) E	3
County Surveyor's C	omment					No. 444	
THIS CORNER RECOR	\	ANCE WITH	I BOARD RU	LE 464(c)		9-30- 0	
REGARDING SUBMITT	AL WITHIN 90 DAYS F	ROM THE D	DATE OF SUR	VEY.			
						OF CA	LIFORING.

(D.D. Sheet No. 62 )

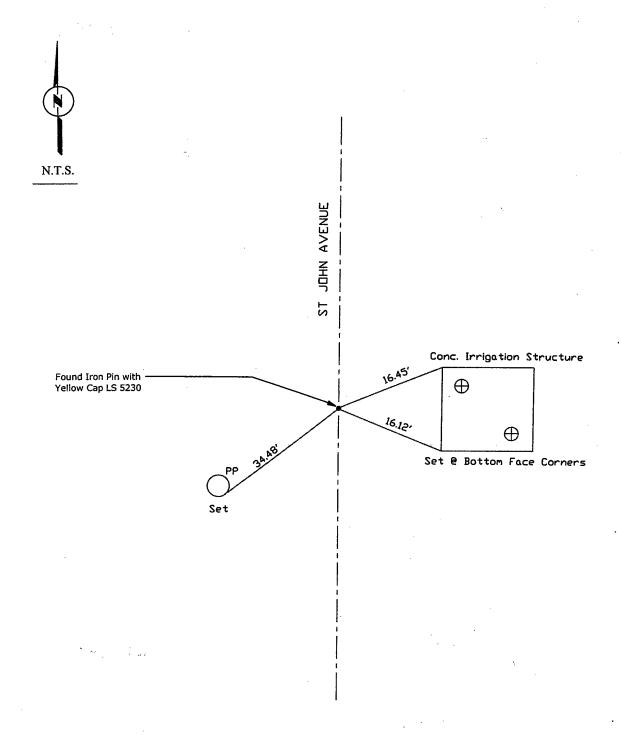

Note: Found Monuments are not tagged unless otherwise noted.

"No Attempt Was Made to Verify the Monument(s)"

FP=Fence Post
GP=Guy Post
JP=Joint Pole
PP=Power Pole
SP=Service Pole
TP=Telephonė Pole
S.F.N=Searched Found Nothing
N.T.S.=Not To Scale
Set=Conc. Nail with Brass Washer Stamped
"S.J. Co.", unless otherwise noted

Note: Set Ties are Brass Washers Stamped "S.J.Co. PUBLIC WORKS"