
CORNER RECORD		De	Document Number CR.08.148			
City of			ounty of	San Joaquin,	California	
Brief Legal Description	n GAWNE ROAD					
	CENTER OF SEC. 36					
	CORNER TYPE			COORDINATES (Optional)		
	Government Corner ☑ Control □		N			
26	Meander			NAD27		
	Rancho 🗆 Other 🗆	-		och		
	Date of SurveyFebruary 14, 2007		Vert. Datu	m: NGVD29 🗆		
TIN R8E	24.3 5. 55. 75.		meas. Unit	s: Metric 🗆	Imperial 🛛	
Corner - Left as fe	ound 🔯 Found and tagged 🗀 Establishe	d $\square$	Reestabl	shed 🔲 Reb	uilt 🗆	
			NOOSIGE:	опос 🗀 кор	оп. <u> </u>	
Identification and tyr	pe of corner found: Evidence used to identify or	proce	dure used to	establish or roost)	ablish the corner	
SEE SKETCH ON BACK		proce	aure usea io	establish of feest	abiish the corner	
SEE SKEICH ON BACK	SIDE.		······································			
				·		
					······································	
		·	·			
A description of the p	physical condition of the monument as found ar	nd as se	et or reset:			
FOUND MONUMENT I	N GOOD CONDITION. SEE SKETCH ON BACKSIDE	Ξ.				
······································				·····		
		<del></del>	·		<del></del>	
				ROFE	SSIA	
	SURVEYOR'S STATEMENT			SED WILL	SOLOMA	
This Corner Record wo	as prepared by me or under my direction in cor	nforma	nce with	The State of the S		
the Land Surveyors'	Act on <u>June 25</u> , 2008.			111111	30890	
$\mathcal{M}$				- Server	\$3/2000	
Signed	R.C.E. Number_ <u>C308</u>	90		STATE	VILORNIA	
(	COUNTY SURVEYOR'S STATEMENT			ATE OF	CALIFOR	
	was received July 3 RD, 2008 and	d eva	mined	Man	ul Son	
and filed <b>Ju</b>	LY 3 RE , 2008.	u exui	illieu .	111871	w Zujk	
	,2008.					
Signed	L.S. No.	6186				
Title Deputy Coun	ity Surveyor			LAMO	***************************************	
	<del></del> U			ED LAND	SUN	
Carrenter Commence camba C	`a mama a n t		•	AS HN G	434	
County Surveyor's C	COMMENT	(c)	//	3/2	2/5/	
		(C)	<b>/</b> /	7/ 2/31/	2010	
KEGAKDING 20RWIIIA	AL WITHIN 90 DAYS FROM THE DATE OF SURVEY.		{	*\ EXP 3/3/1	-   *	
DD Shoot No. 20	7		\	LIC. #618		
D.D. Sheet No. 39 Job No. 750108)	)		`			

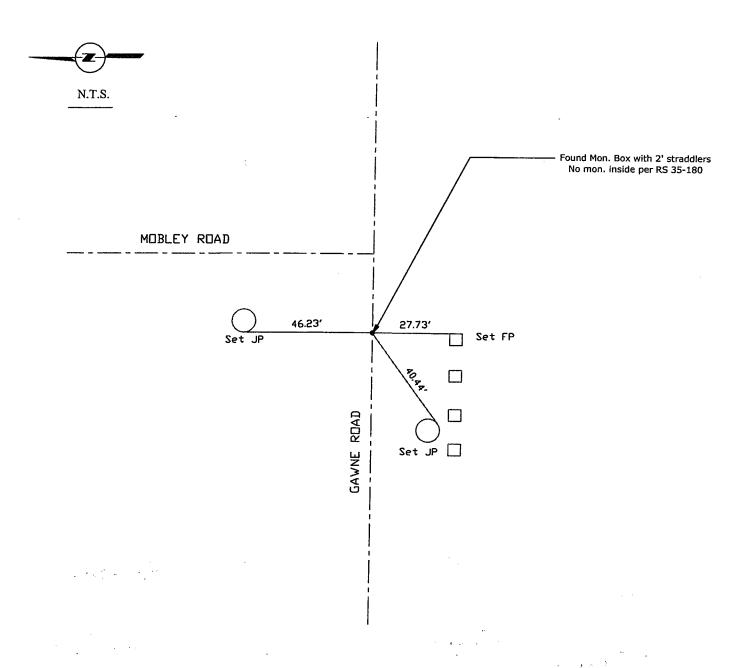

Note: Found Monuments are not tagged unless otherwise noted.

"No Attempt Was Made to Verify the Monument(s)"

FP=Fence Post
GP=Guy Post
JP=Joint Pole
PP=Power Pole
SP=Service Pole
TP=Telephone Pole
S.F.N=Searched Found Nothing
N.T.S.=Not To Scale
Set=Conc. Nail with Bross Washer Stamped
"S.J. Co.", unless otherwise noted

Note: Set Ties are Brass Washers Stamped "S.J.Co. PUBLIC WORKS"