

CORNER RECORD				Document Number CR 08 · 154			
City of				County o		San Joaquin,	Californic
Brief Legal Description	GAWNE ROAD						
	CENTER OF SEC. 32			<u> </u>			
	COR		coo	RDINATES (Op	tional)		
		671 0	, , , , , , , , , , , , , , , , , , , ,	N	·		
	Government Corner		ontrol $\square$	Zone		NAD27	□ NAD83 □
	Meander <sub>.</sub> Rancho		operty 🗆 .	NAD	33 Epoch		
					Datum:	NGVD29 □	NAVD88 🗆
TIN R9E	Date of SurveyAu	igust 1, 200	<u> </u>			Metric	
Corner - Left as fo	ound 🔲 Found and tag	gged 🗆	Established	☐ Ree	stablishe	ed 🗌 Rebi	uilt 🛛
Identification and type SEE SKETCH ON BACKS	e of corner found: Evider SIDE.	nce used t	o identify or p	procedure us	ed to est	tablish or reesto	ablish the corner
				· · · · · · · · · · · · · · · · · · ·			
				···· ,	*		
		· <del></del>	-A				
			· · · · · · · · · · · · · · · · · · ·				
	hysical condition of the m						
FOUND MONUMENT IN	GOOD CONDITION. PL	ACED MO	NUMENT WELL	. OVER MON	UMENT. S	SEE SKETCH ON	BACKSIDE.
							<del></del>
	<u> </u>					····	
						OCES	2010
	SURVEYOR'S STATEM					ED SIJEL S	SOLONAL
	is prepared by me or und	-		ormance wit	h	Salar Salar	
	Action Jalune 25		, 2008.			No. C3	1 ) [ [ ] ]
Signed Monue	el assorio F	R.C.E. Nur	mber <u>C3089</u> (	0		CERTIFICS 3/	3/2010   =
	· .					STATE OF C	IL ORNIA
TI: 0	OUNTY SURVEYOR'S ST	AISMENI	<i>y</i>			01.6	
	vas received Juch		, 2008 and	examined		Monuel	Dolores
and filed <u>JUL</u>		, 2008.					•
Signed	nG. May		L.S. No6	186			
Title Deputy Count	y Surveyor					LAND	
	J					SEDING	SUP
County Surveyor's Co	omment			•	1	SOHII O	19/E
,	IS NOT IN COMPLIANCE	WITH BOA	RD RULE 464(c		- [[3]	) alaula	12/2
REGARDING SUBMITTA	L WITHIN 90 DAYS FROM	THE DATE O	OF SURVEY.			EXP. 3 31	LUID
			<u></u>	· · · · · · · · · · · · · · · · · · ·	_	LIC. #618	6 /
D.D. Sheet No. 40 )					- /3		
Job No. 750108)					4	FOF CAL	IFON:
						UNI	Name of the last o

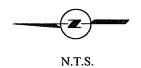

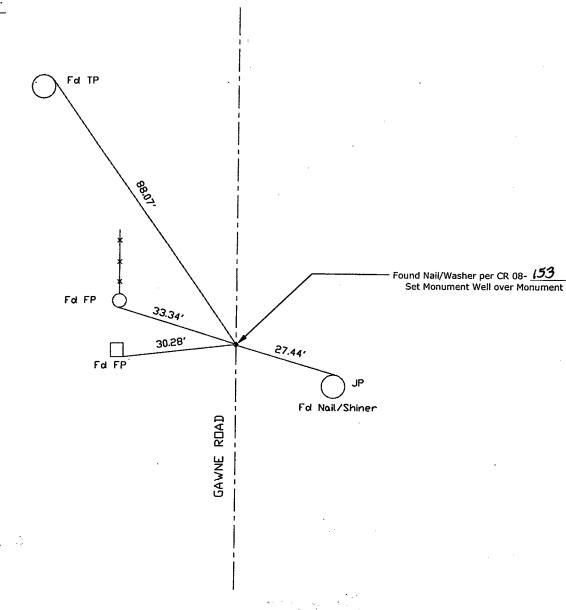

Note: Found Monuments are not tagged unless otherwise noted.

"No Attempt Was Made to Verify the Monument(s)"

FP=Fence Post
GP=Guy Post
JP=Joint Pole
PP=Power Pole
SP=Service Pole
TP=Telephone Pole
S.F.N=Searched Found Nothing
N.T.S.=Not To Scale
Set=Conc. Nail with Brass Washer Stamped
"S.J. Co.", unless otherwise noted

Note: Fd Ties are Brass Washers Stamped "S.J.Co. PUBLIC WORKS" per CR 08-153 unless otherwise noted