
CORNER RECORD		Document Number CR-09-02		
City of		County of	San Joaquin,	Californi
Brief Legal Description _	BENEDICT DRIVE @ LARK STREET IN TOWN OF V	WOODBRIDGE		
	(WITHIN SECTION 34, TOWNSHIP 4 NORTH, RANGE 6 EAST)			
	CORNER TYPE	CC	DORDINATES (Op	tional)
	Government Corner Control	N		-1
	Meander	Zone	NAD27	□ NAD83 □
	Rancho ☐ Other ☒	NAD83 Epo	ch	
	Date of Survey November 12, 2008	Vert. Datur	n: NGVD29 🗆	NAVD88 🗆
	Daile 01 001 10)	Meas, Units	: Metric 🗆	Imperial 🛮
				7
Corner - Left as fou	nd 🛛 Found and tagged 🗌 🛮 Established (☐ Reestabli:	shed 🗌 Reb	uilt 🔲
dentification and type	of corner found: Evidence used to identify or pro	cedure used to	establish or reesta	ablish the come
EE SKETCH ON BACKSIE	DE.			
~~~~~~~~~~~~~~~~~~~~~~~~~~~~~~~~~~~~~~				
A description of the phy	sical condition of the monument as found and a	s set or reset:		
EE SKETCH ON BACKSID				***
				<del></del>
			***************************************	·····
,			(1)	ANG
	SURVEYOR'S STATEMENT		ONAL	RGE
his Corner Record was p	orepared by me or under my direction in conforr	nance with		100
ne Land Surveyors' Ac	et on $12/19/08$ , 2008.			NCE Z
7 -				8470 = C
igned/	P.L.S. Number 8470	<del></del>	NO.	/*
	MNTY SURVEYOR'S STATEMENT		M Co	2/31/10/11
his Corner Record wa	is received <u>12/24/08</u> , <del>2008</del> and ex	kamined	STATE OF	2/311 CRITICORNIL
nd filed <u>Janua</u>	<u>ry 8</u> ,200 <b>g</b> .		OF OF	CALITY
gned John	G. May P.L.S. No. 618	,	_	
tle Deputy County		0		LAND C
ne <u>Deputy County</u>	V		SE OF	NG
ounty Surveyor's Con	oment		(A) (A)	TAX.
Outly surveyors Con	nment			3/31/2010
			<b>★</b> EXP	
				IC. #6186
D.D. Sheet No. 12A)				- ARY
ob No. 220772)			15	OF CALIFOR



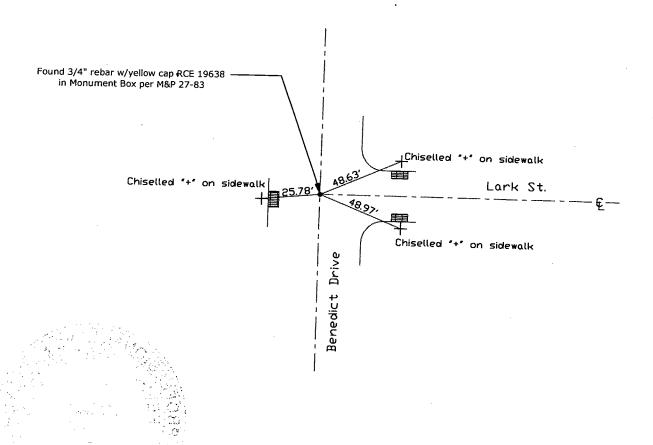

Note: Found Monuments are not tagged unless otherwise noted.

"No Attempt Was Made to Verify the Monument(s)"

FP=Fence Post
GP=Guy Post
JP=Joint Pole
LP=Lamp Pole
PP=Power Pole
RS=Record of Survey
SP=Service Pole
IP=Telephone Pole
S.F.N=Searched Found Nothing
N.T.S.=Not To Scale
Set=Conc. Nail with Brass Washer Stamped
"S.J. Co.", unless otherwise noted