
CORNER	RECURD			D	ocument Nu	mher	10-2	20
City of	<u> </u>				ounty of			California
Brief Legal Des	cription <u>VON SOSTEN R</u>	OAD @ HANSE	N ROAD & 2	2617.71' EA	ST OF HANSE	N ROAD		
	NORTHWEST C							
		CORNER T				OORDINATE	 SitaOl 8	 onal)
	Covernmen	t Corner ⊠	<b>O</b> 1: 1 (	<b></b> ,	N			_
73	Meander	Comer 🗷	Control ( Property (		<u>_</u> .			□ NAD83 □
20	Rancho			_	NAD83 Epo	och		
	Dela efficie	Manuala 17	•		Elev Vert. Datur	n: NGVD2	29 🗆	NAVD88 🗆
T2S R4E M.D.B.&M.	— Date of 20th	ey <u>March 16</u>	, 2010			: Metric	_	Imperial 🛛
Corner - Le	eft as found 🛛 Found	and tagged	☐ Establi	shed 🔲	Reestabli	shed	Rebuill	
Identification		t. F . 1				<del> </del>	-	
SEE SKETCH ON	nd type of corner found BACKSIDE							ish the comer:
	· · · · · · · · · · · · · · · · · · ·	· · · · · · · · · · · · · · · · · · ·						
	······································						<del></del>	·
							<del></del>	<del></del>
A description of	the physical condition			d and as sa		<u> </u>	······································	<del></del>
SEE SKETCH ON	the physical condition							
								·
				·· ····		.20	<del></del>	
			· · · · · · · · · · · · · · · · · · ·	······································				
						<del></del>		· · · · · · · · · · · · · · · · · · ·
	SURVEYOR'S S	TATEMENT				. 1	IAN	
This Corner Reco	ord was prepared by me	or under my	direction in a	onforman	ce with	SIONAL	JORGA	
		A 7	, 2010.			15/2	ν ν ν ν ν ν ν ν ν ν ν ν ν ν ν ν ν ν ν	10/2
Signed 74	T I	P.L.S. Nu	- · · -			SP 11	CENSE	= 3
oigrica 2		F.L.S. NU	mber <u> 6470</u>	_	((		. 8470	
	COUNTY SURVEY					10/10	1.	0/4/
	cord was received	APRIL :	<b>Z</b> , 2010 c	and exam	ined	(1) (1) (1) (1) (1) (1) (1) (1) (1) (1)	12/31	<u> </u>
and filed	P2/C 8	, 2010.				OF	CALIF	
Signed	roman M. To	m	_R.C.E. No.	. 23341			$\equiv$	
Title County Su	urveyor					PROFF	SSION	2
					/	AU CON	5 M.	\`C\\\\\
County Surveyo	or's Comment				· //s	5/2		200
· ·						No.	26994	
						EXP.	3-31-	
					//	(2)	. \	\Z
D.D. Sheet No.	52 )					1355 T	VIL	(\$ <sup>7</sup> //

Job No. 220792

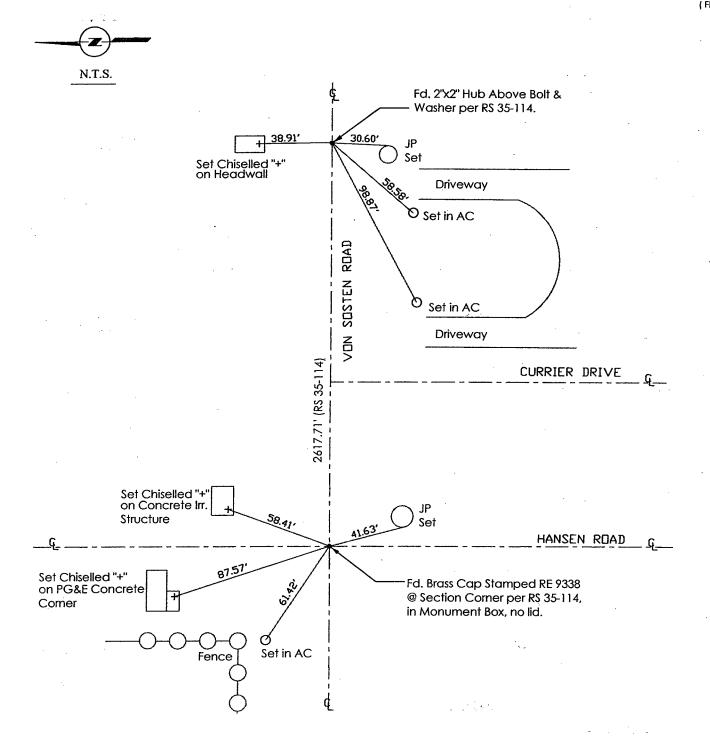

Note: Found Monuments are not tagged nor of Record, Unless otherwise noted.

"No Attempt Was Made to Verify the Monument(s)"

Fd.=Found
AC=Asphalt Concrete
GP=Guy Post
JP=Joint Pole
PP=Power Pole
SP=Service Pole
TP=Telephone Pole
S.F.N=Searched Found Nothing
N.T.S.=Not To Scale
Set=Conc. Noil with Brass Washer Stamped
"S.J. Co.", unless otherwise noted