
CORNER RECORD				Document Number CR-10-25		
City of				County of	San Joaquin,	California
Brief Legal Description	SOUTHLAND ROAD 20	098' +/- EAST C	OF AUSTIN RO	AD		
	(WITHIN SECTION 26, TO	OWNSHIP 1 SC	OUTH, RANGE	7 EAST, MOUN	T DIABLO BASE & M	IERIDIAN)
<del>,</del>	CORNER TYPE			COORDINATES (Optional)		
	Government Corner	- □ Contr	ol 🗀	Ю E		
	Meander		erty 🗆	Zone	NAD27 och	☐ NAD83 ☐
	Rancho	☐ Other	×	Elev		
	Date of SurveyF	ebruary 10, 20	010	Vert. Datu Meas. Unit	m: NGVD29  s: Metric	NAVD88 ☐ Imperial ☒
		٠,			. Meme B	imperior M
Corner - Left as fou	ind 🛛 Found and tag	gged 🗆 E	istablished [	] Reestabl	shed 🗌 Rebu	uilt 🔲 .
Identification and type	of corner found: Evider	nce used to id	lontify or pro-	and its used to	actablish as so sale	A-17-1- Bl
SEE SKETCH ON BACKSIL		ice osed io ic	terminy of pro-	redute used to	establish of feesta	iblish the come
	33.8. S. 1. 1. 1. 1. 1. 1. 1. 1. 1. 1. 1. 1. 1.					
· · · · · · · · · · · · · · · · · · ·						-1
A description of the phy	sical condition of the m	nonument as	found and as	set or reset:		
FOUND MONUMENT IN C	GOOD CONDITION. SEE	E SKETCH ON E	BACKSIDE.			
· · · · · · · · · · · · · · · · · · ·	·					
		1.		······································		•
					NI I	ANO
	SURVEYOR'S STATEMI				CIONAL L	SC 5
This Corner Record was				nance with	SI LICEN	
the Land Surveyors' Ac					PR LICEN	SE = S
Signed	The P	P.L.S. Numbe	r <u>8470</u>	<del></del>	\\ <b>★</b> \ No. 8 <sup>2</sup>	
Che	DUNTY SURVEYOR'S ST.	ATEMENT			100/00	10/2
This Corner Record wo			2010 and ex	amined	7 12/3	168
	<u>. 8</u>				OF CA	LIFOR
signed Thomas	M. Fan	R.C	.F. No. 2334	1	OFFSSI	2
itle County Surveyo					PROFESSION S M	
					SOMAS M	66
County Surveyor's Cor	nment				SS 12 200	012/19
			-		No. 269 EXP. 3−3	
						\\\\\\\\\\\\\\\\\\\\\\\\\\\\\\\\\\\\\\
DD Shoot No. 141			<del></del>	···	JA CIVI	
D.D. Sheet No. 46) Job No. 220792)					OF CAL	140/

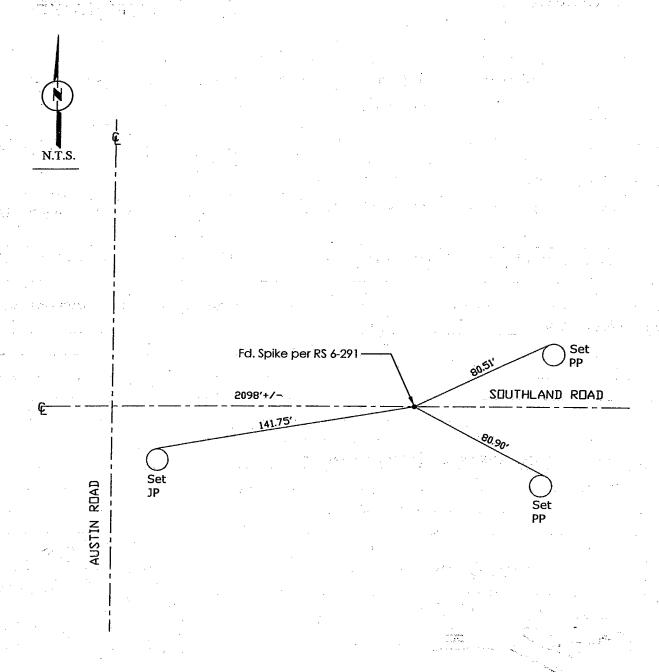

Note: Found Monuments are not tagged unless otherwise noted.

"No Attempt Was Made to Verify the Monument(s)"

Set=Conc. Nail with Brass Washer Stamped
"S.J. Co.", unless otherwise noted
Fd.=Found Conc. Nail with Brass Washer Stamped
"S.J. Co.", unless otherwise noted
FP=Fence Post
GP=Guy Pole
JP=Joint Pole
PP=Power Pole
SP=Service Pole
TP=Telephone Pole
S.F.N.=Searched Found Nothing
N.T.S.=Not To Scale
M&P=Maps & Plats
PM=Parcel Map
RS=Record of Survey
FB=Field Book