
CORNER RECO	Documen	Document Number <u>CR-10-62</u>			
City of		County of		an Joaquin,	California
Brief Legal Description _	CORRAL HOLLOW ROAD @ LARCH ROAD		her the three forces are the second as a second as	Hallian Market	
	(WITHIN RANCHO EL PESCADERO)				
	CORNER TYPE		COOR	DINATES (Opi	tional)
	Government Corner Control	N E. '			
	Meander	Zone_		NAD27	□ NAD83 □
	Rancho ☐ Other 🗵	NAD8 Elev.	3 Epoch_		
	Date of Survey September 13, 2010	Vert. [Datum: Units:	NGVD29 □	NAVD88
INTERSECTION POINT WA	AS REESTABLISHED BASED ON TIES FROM CR				Imperial 🖾
	nd Found and tagged Establish	····			Jilt ⊠
	Table 1 to the analysis of the control of the contr			. El yenr	
SEE SKETCH ON BACKSID					
		·		······································	
					
					
SEE SKETCH ON BACKSID					
	SURVEYOR'S STATEMENT prepared by me or under my direction in co		• //	SONAL LA	4NO 560 SCO
the Land Surveyors' Ac		MONTION CE WIN	//4		18/E
Signed 74	P.L.S Number 8470	e.	PROF	D LICENS	
	,	,	*	No. 84	10
	UNTY SURVEYOR'S STATEMENT s received <i>September</i> 30, 2010 ar	. al	1/0	12/3	11/2/2
	868 7 , 2010 dr	na examinea	/	OF CAL	IFOX
av.	n1 41			07.0	
		23341		PROFESS/	ONV
Title County Surveyo	r			DIAS M	
			//4	-\(\(\eta_{\eta_{\eta}}\)	0/2//
Company of the Company of the Company	n inn n vn. vn. f		<i>- [[/;</i> ;;		2/2/1
County Surveyor's Com	nment		EGISZ	No. 269	194
County Surveyor's Com	nment		*RECIST	No. 269 EXP. 3-3	994 1-11 ★
County Surveyor's Com	nment		S *REGIST		

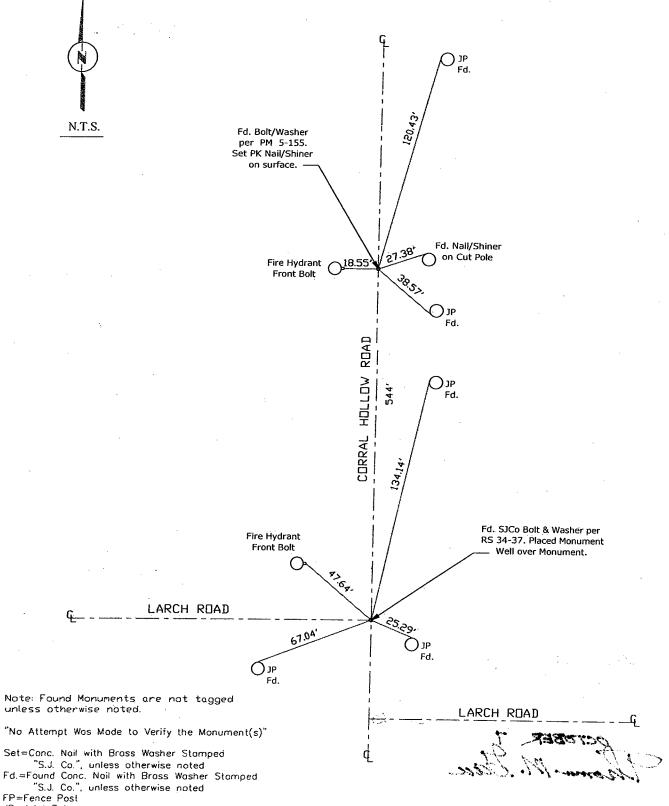

30

JP=Joint Pole
LP=Light Pole
PP=Power Pole
SP=Service Pole
TP=Telephone Pole
S.F.N.=Searched Found Nothing
N.T.S.=Not To Scale
M&P=Mops & Plots
PM=Parcel Map
RS=Record of Survey
F8=Field Book