
## **CORNER RECORD**

BORPELS -1297

			Document	Number	CR-10.	-73
City of STOCKTON			County of		'N	
Brief Legal Description	IN SECTION 49, C	C.M. WEBER GRA	WT			
	CORNER TYPE			COORDINATES (Optional)		
	Government Corne	r	П	N		
	Meander	☐ Property		Zone	NAD2	7 NAD83
ž.	Rancho	Other		NAD83 Epoch		
	Date of Survey	AUGUST 16, 20	210	Elev. Vert. Datum: Meas. Units:	. —	NVGD88  Imperial
Corner— Left as foun	d Found and	tagged Est	ablished [	Reestab	lished 🛛 R	Rebuilt 🔲
Identification and type of co	rner found: Evidence	used to identify	or procedure	used to estab	olish or reestat	lish the serve
CENTERLINE MONUMENT	S ARCH-AIRPORT	ROAD 275± NO	RTHWEST (	OF QANTAS L	ANE.	mon the come
MONUMENTS DESTROYER						
RESET FROM TIES AS S	SHOWN ON PAGE 2	2				
<del></del>	· · · · · · · · · · · · · · · · · · ·					
		- - -	·			
	SURVEYOR'S ST	FATEMENT			SSESSESSESSESSESSESSESSESSESSESSESSESSE	D SUA
This Corner Record was prep	ared by me or under	my direction in c	onformance	with	SON WAY	Che Co
the Land Surveyors' Act on _	OCTO	<u>OBER 11, 2</u>	<u>010</u> ,		* * *	R * Y
////	•				10. 64	06 OF \$
Signed Jul (	P.L.S	S. <del>or R.C.E.</del> Numbe	er <i>6406</i>	<u> </u>	AND OF CA	T. L.
	COUNTY SURVEYOR'	's statement			PROFES	SSION
This Corner Record was recei	ved OCTOBER	1/2 20	iO and	examined //	EREC HOMAS	M. C.
and filed NOVEMBE					8/140.	OF SE
Signed Momes M.	Hou P.	<del>S. or</del> R.C.E. No:	233	41		
itle <u>COUNTY SC</u>		_		\\*	No. 26 EXP. 3-31	
County Surveyor's Comment_			·		CIVI	11 /2/
				<u> </u>	OF C	ALIFORNI
<del></del>			<del></del>			
	<del></del>			<del></del>		<del></del>

Page 1 of 2

D.D. Sheet No. 35

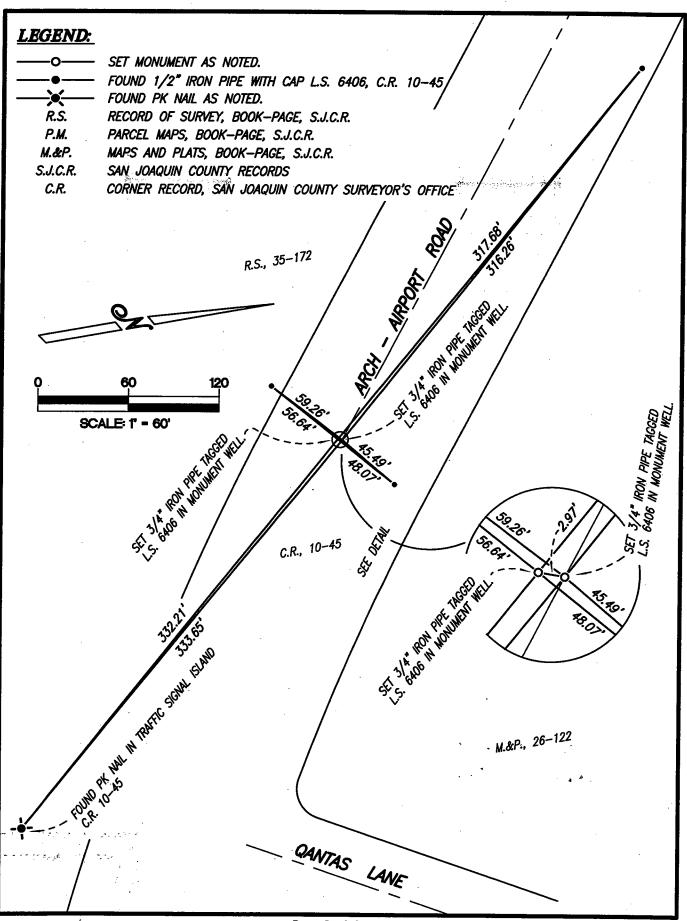

Page 2 of 2