
CORNER RECORD				Docuir	nent Nun	nber	CR-11-09		
City of				Count			aquin,	California	
Brief Legal Description ACA	MPO ROAD	1630'± WE	EST OF DES MOINE	ES ROAD		- <del></del>			
(WITI	IN SECTION 2	4 , TOWNSH	HIP 4 NORTH, RAN	IGE 6 EAS	T, MOUN	DIABLO	BASE & A	MERIDIAN)	
Me Ra	overnment Co eander ncho		Control □ Property □ Other ⊠	E. Zo Na Ele	 one	och	_NAD27	□ NAD83 □	
	ate of Survey _		☐ Established		eas. Units Reestabli			Imperial ⊠	
Identification and type of co SEE SKETCH ON BACKSIDE.			ed to identify or p						
A description of the physical SEE SKETCH ON BACKSIDE.	Containor	· 	iem us rooma uni						
This Corner Record was prep the Land Surveyors' Act o Signed	n Fe	or under my ebruary 1 	, 2011. Number <u>8470</u> IENT			PROFESS KEWESS	LICEN No. 8		
This Corner Record was read filed Ebyuany	_	2011	1.		ed	13.5	OF CI	LIFOR W	
Signed	yor	Illic	R.C.E. No.	26994			ROFESS	BIONAL EN	
County Surveyor's Comme	ent					S *REGISTA	No. 26 XP. 3-	5994 31-11 ★	
(D.D. Sheet No. 12 ) Job No. 220011	······································				<del></del>		OF CE	LIFOR	

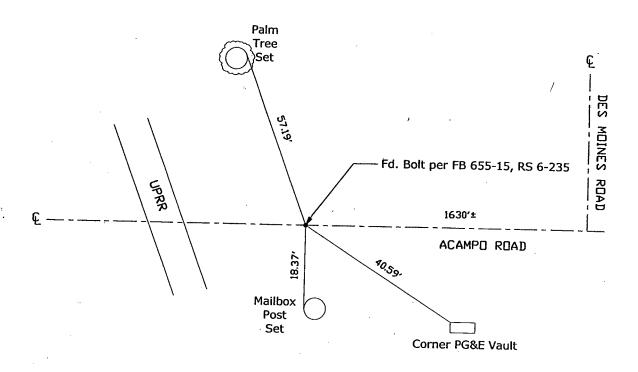

N.T.S.



Note: Found Monuments are not tagged unless otherwise noted.

"No Attempt Was Made to Verify the Monument(s)"

Set=Conc. Nail with Brass Washer Stamped
"S.J. Co.", unless otherwise noted
Fd.=Found Conc. Nail with Brass Washer Stamped
"S.J. Co.", unless otherwise noted
FP=Fence Post
JP=Joint Pole
LP=Light Pole
PP=Power Pole
GP=Guy Pole
SP=Service Pole
ITP=Telephone Pole
S.F.N.=Searched Found Nothing
N.T.S.=Not To Scale
M&P=Maps & Plots
PM=Parcel Mop
RS=Record of Survey
FB=Field Book