
CORNER REC	ORD	Docun	nent Numl	per <u>CR 1</u>	2-142
City of			y of	San Joaquin,	
Brief Legal Description	BETHANY ROAD @ REEVE ROAD				
	(WITHIN RANCHO EL PESCADERO)				
	CORNER TYPE	N	COORDINATES (Optional)		
	Government Corner  Control  Meander  Property  Rancho  Other	Zoi NA	ne D83 Epoc	NAD27 h	□ NAD83 □
	Date of Survey September 2, 2011	Ve		NGVD29  Metric	NAVD88 ☐ Imperial ☒
Corner - Left as fo	ound  Found and tagged  Established	☐ R	eestablish	ed 🔲 Rebi	uilt 🛭
Identification and type SEE SKETCH ON BACKS	e of corner found: Evidence used to identify or paid.			stablish or reesto	ablish the corner:
			-		
	the state of the s				
	IDE.		· · · · · · · · · · · · · · · · · · ·		
			,	·	
This Corner Record was	SURVEYOR'S STATEMENT s prepared by me or under my direction in confo	rmance v	vith /	SINES !	LAND SERVICE
Signed James	P.L.S. Number 8657			PROF FICEI	
	OUNTY SURVEYOR'S STATEMENT		\	1/2/2	13/2/
and filed APRIL	ras received <u>AM21C</u> 12, 2012 and 6	examine	d ·	77. 12 OF C	ALIFOR ALIFORN
Signed Nom	M. Bau R.C.E. No. 26	994			
Title County Surveyo	or		,	PROFESS SELLOMAS	M. CA
County Surveyor's Co	mment		_ //		是黑
<del></del>	D IS NOT IN COMPLIANCE WITH BOARD RULE 464(c	c)	([	SOJ No. 26 ★ EXP. 3-	31116
REGARDING SUBMITTA	AL WITHIN 90 DAYS FROM THE DATE OF SURVEY.	<del></del>	//	★ \ EXP. 3 \ い.\	31-13/★/
(D.D. Sheet No. 52) (Job No. 220009)			`	PF OF CA	THORE



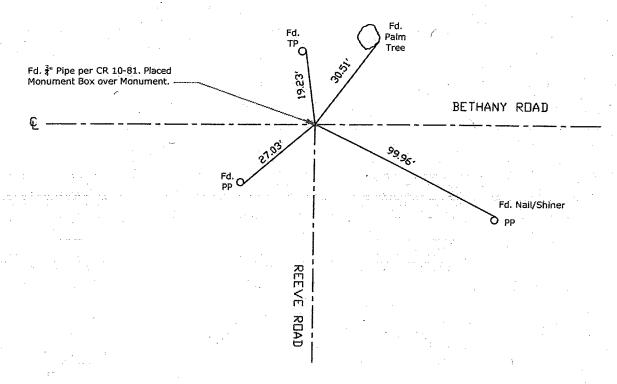

Note: Found Monuments are not tagged unless otherwise noted.

"No Attempt Was Made to Verify the Monument(s)"

Set=Conc. Nail with Brass Washer Stamped
 "S.J. Co.", unless otherwise noted
Fd.=Found Conc. Nail with Brass Washer Stamped
 "S.J. Co.", unless otherwise noted
CR=Corner Record
FP=Fence Post
JP=Joint Pole
LP=Light Pole
PP=Power Pole
GP=Guy Pole
SP=Service Pole
TP=Telephone Pole
S.F.N.=Searched Found Nothing
N.T.S.=Not To Scale
M&P=Maps & Plats
PM=Parcel Map
RS=Record of Survey
FB=Field Book