
CORNER RECORD			Document Number <u>CR-12-381</u>			
City of			ounty of		California	
Brief Legal Description	ESCALON BELLOTA ROAD 2649'	+/- NORTH OF SKIF	F ROAD	•		
	CORNER TYPE			ORDINATES (Opti		
	Government Corner 🛛 Con	trol 🗆	E			
<b>5</b>		erty 🗆	Vone NAD83 Epoc	NAD27 h	□ NAD83 □	
	Rancho 🗆 Othe		Elev	NGVD29 □		
TIS R9E	Date of Survey September 21	, 2012	Meas. Units:		NAVD88 ☐ Imperial ☒	
Corner - Left as fou	nd  Found and tagged	Established	Reestablish	ed 🔲 Rebui	ilt 🛛	
Identification and type	of corner found: Evidence used to	identify or proced	dure used to e	stablish or reestat	olish the corner	
SEE SKETCH ON BACKSIE	· <del></del>					
<del></del>						
A description of the order		_			<del></del>	
A description of the phy SEE SKETCH ON BACKSID	sical condition of the monument as			-		
OLL ONLICH ON BACKSID	<b>L.</b>					
				· · · · · · · · · · · · · · · · · · ·		
	· ·					
	SURVEYOR'S STATEMENT			ONAL L	AND	
	orepared by me or under my direct	lion in conforman	nce with	SOMES E.	132.14	
the Land Surveyors' Ac					7名(色)	
Signed James	E Hart P.L.S. Number	er <u>8657</u>		F TICEN		
co	OUNTY SURVEYOR'S STATEMENT			\★\ No. 8	65/	
This Corner Record wo	s received OCTOBER 25	2012 and exam	nined	7 to 12	31/2/	
and filed <u>Januar</u>	<u>9 16</u> , 201 <b>3</b> .		•	OF CA	LIFOR	
Signed / Norma	M. Han R.C	C.E. No. <u>26994</u>		$\Rightarrow$		
Title <u>County Surveyor</u>				PROFESSI	ONA	
				SE SUNAS M		
County Surveyor's Con	nment		——		艺剧	
	·			No. 269 EXP. 3−3		
		<del></del>		<b>声</b> / LAF、リーン (い)	1-13	
D.D. Sheet No. 43 )		<del></del>	<del></del>	EIVI		
Job No. 2200031				OF ON	750//	



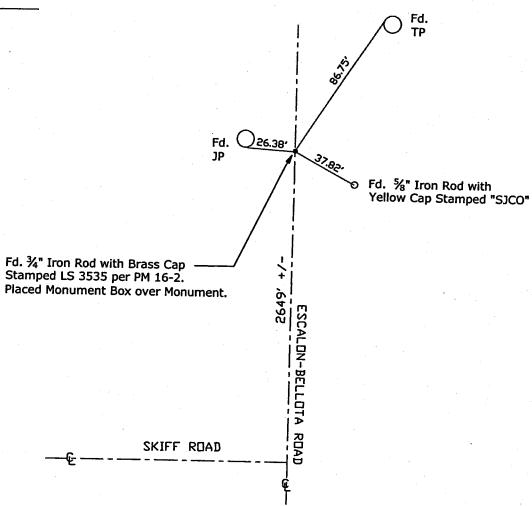

.

Note: Found Monuments are not tagged unless otherwise noted.

"No Attempt Was Made to Verify the Monument(s)"

Set=Conc. Nail with Brass Washer Stamped
"S.J. Co.", unless otherwise noted
Fd.=Found Conc. Nail with Brass Washer Stamped
"S.J. Co.", unless otherwise noted
CR=Corner Record
FP=Fence Post
JP=Joint Pole
LP=Light Pole
PP=Power Pole
GP=Guy Pole
SP=Service Pole
TP=Telephone Pole
S.F.N.=Searched Found Nothing
N.T.S.=Not To Scale
M&P=Maps & Plats
PM=Parcel Map
RS=Record of Survey
FB=Field Book