
CORNER RECORD  City of		Document Number CR-12-396			
			ounty of	San Joaquin,	
Brief Legal Description _	BRIGHT ROAD @ SNEED ROAD			•	
	WITHIN SECTION 2, C.M. WEBER GRANT				
	CORNER TYPE	COORDINATES (Optional)			
	Government Corner   Control		Ŀ		
	Meander □ Property □		Zone	NAD27 och	□ NAD83 □
	Rancho 🗆 Other 🖾		Elev		
	Date of Survey September 25, 2012			rm: NGVD29 🗆 ts: Metric 🗆	NAVD88 □ Imperial 🏻
Corner - Left as fou	nd 🛮 Found and tagged 🔲 Established		Reestab	lished 🔲 Reb	uilt 🗀
Identification and type	of corner found: Evidence used to identify or p	proced	dure used to	establish or reesto	ablish the corner:
SEE SKETCH ON BACKSIE				·	
				·	
A description of the phy	sical condition of the monument as found and	d as se	t or reset:_		
SEE SKETCH ON BACKSID	DE.				
			······································		·
TI. 0	SURVEYOR'S STATEMENT			ONAL	LAND
	prepared by me or under my direction in conf	ormar	nce with	SOLES	E. March
<b>/</b> 1	ct on October 26, 2012.			11 🔾 1	NSE R
Signed James	P.L.S. Number 8657			(E) LICE	NSE 의
cc	DUNTY SURVEYOR'S STATEMENT			<b>★</b> No.	8657 /★//
	as receivedoctober 26 , 2012 and	exar	nined	12 to 12	131/3/2
and filed <u>Januar</u>	2.0	· • · · · · · · · · · · · · · · · · · ·		COF C	ALIFOX
Signed Nome	<u>-M. Han</u> R.C.E. No. 2	V004			N.C.
Title County Surveyo		0774		PROFES	SIONAL
ille <u>coomy solveyo</u>				WAS	M. Call
County Surveyor's Cor	nment				S S
Coorny sorveyors cor	mment			No. 2	6994
			<del></del>	No. 2 EXP. 3-	31-13 /₹//
			<del></del>		[4]
(D.D. Sheet No. 34 )				AXX OF V	1505/



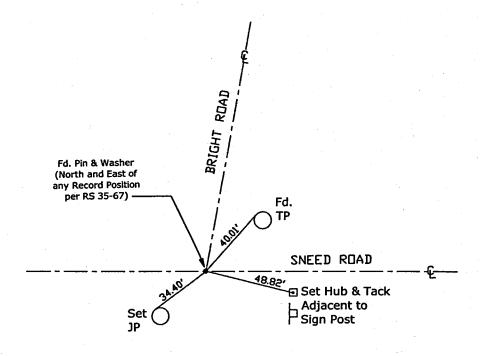

Note: Found Monuments are not tagged unless otherwise noted.

"No Attempt Was Made to Verify the Monument(s)"

€.