
CORNER RECORD		Document Number CR-12-451			
		County of		San Joaquin,	California
Brief Legal Description_	LIVE OAK ROAD 209' +/- EAST OF NORTH 99 F	RONTAGE RC	AD		
	CTION 30, TOWNSHIP 3 NORTH, RANGE 7 EAST, N			& MERIDIAN))	
	CORNERTYPE		CC	ORDINATES (Opt	ional)
	Government Corner   Control	N E.		NAD27	
	Meander	Zone		NAD27	□ NAD83 □
	Rancho 🗆 Other 🛛	NADS Elev	3 Epo	ch	· - · · · · · · · · · · · · · · · · · ·
	Date of Survey October 15, 2012	Vert.	Datur	n: NGVD29 🗖	
		Meas	i. Unns	: Metric 🛘	Imperial 🛮
Corner - Left as fou	und 🛛 Found and tagged 🔲 Established	l □ Ree	establi.	shed □ Reb	uilt 🔲
dentification and type	e of corner found: Evidence used to identify or	procedure u	sed to	establish or reesto	ablish the corner
SEE SKETCH ON BACKS	IDE.				
					·
A description of the ob	visited and ities of the manuscript or found and	l as sat as ross	. 4.		
	nysical condition of the monument as found and				
SEE SKETCH ON BACKS	IDE.			<u></u>	
			<del></del> -		
				<del></del>	<del></del>
		· · · · · · · · · · · · · · · · · · ·			
	SURVEYOR'S STATEMENT			NAL	LAND
	as prepared by me or under my direction in con	formance wit	h.	ESTES	E. H
the Land Surveyors' A	Act on November 13, 2012.			13/2 2	72/6
Signed Jam	P.L.S. Number 8657			LIE LIC	ENSE S
		<u> </u>		\\ <b>★</b> \ No.	8657 / ★
	COUNTY SURVEYOR'S STATEMENT			1/2/4	171/2/2
,	vas received NOVEMBER 13 , 2012 and	d examined		OF OF	2131/68
and filed Kinda	pry 16, 2013.			OF	CALIT
Signed Kom	an M: Have R.C.E. No.	26994		att.	CCIO
Title County Survey	yor			PROFE	SSIONAL
				W SON P.	) M.
County Surveyor's C	omment				2/2
, ,				11021	26994
				\ <b>\`≨</b> \ EXP. 3	3-31-13 /
					W &
(D.D. Sheet No. 16)				W. O.E.	V1/1608/
(Job No. 220054)					UALI

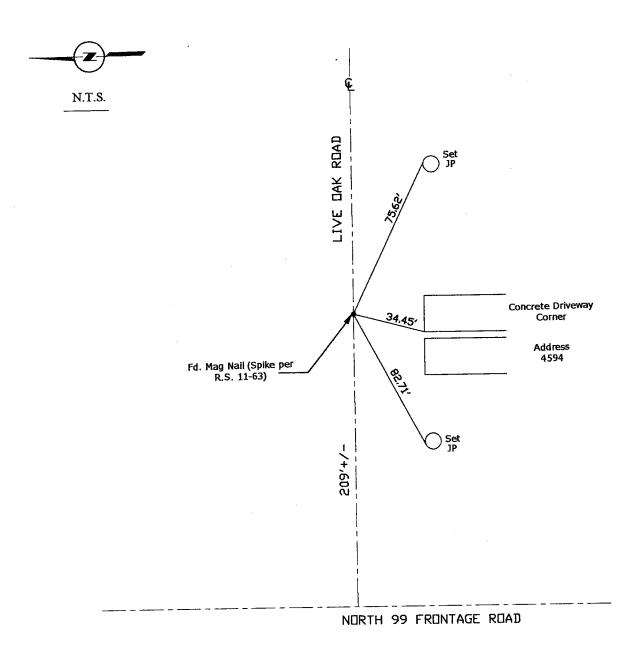

Note: Found Monuments are not tagged unless otherwise noted.

"No Attempt Was Made to Verify the Monument(s)"

Set=Conc. Nail with Brass Washer Stamped
"S.J. Co.", unless otherwise noted
Fd.=Found Conc. Nail with Brass Washer Stamped
"S.J. Co.", unless otherwise noted
FP=Fence Post
JP=Joint Pole
LP=Light Pole
LP=Light Pole
EP=Guy Pole
GP=Guy Pole
SP=Service Pole
TP=Telephone Pole
S.F.N.=Searched Found Nothing
N.T.S.=Not To Scale
M&P=Maps & Plats
PM=Parcel Map
RS=Record of Survey
FB=Field Book