
| CORNER RECO                             | Document Number <u>CR-12-488</u>   |  |   |             |                         |
|---|--|--|---|-------------|-------------------------|
| City of                                 |  | County of                                  |   | Joaquin,    | California              |
| Brief Legal Description _               | CURRY AVENUE @ SARGENT ROAD  | , , , , , , , , , , , , , , , , , , ,      |   | •           |                         |
|   | (WITHIN SECTION 8, TOWNSHIP 3 NORTH, RANG  | GE 7 EAST)                                 |   |             |                         |
|   | CORNER TYPE  | COORDINATES (Optional) N                   |   |             |                         |
|   | Government Corner  | Zone_<br>Zone_<br>NAD83<br>Elev<br>Vert. D | Epoch   | NAD27       | NAD83                   |
|   | Daie of solvey   | Meas.                                      | Units: Me   | etric 🗆     | Imperial 🛛              |
| :                                       | nd 🛛 Found and tagged 🔲 Established of corner found: Evidence used to identify or pr |  | tablished <b>5</b>  |             | ilt   blish the corner: |
| SEE SKETCH ON BACKSIE                   | DE.  |  |   |             |                         |
|   |  |  |   |             | <del></del> .           |
| · · · · · · · · · · · · · · · · · · ·   |  |  |   |             |                         |
|   |  |  |   |             | ·                       |
|   |  |  |   | <del></del> | <del> </del>            |
|   | rsical condition of the monument as found and  | as set or rese                             | t:  | ·           |                         |
| SEE SKETCH ON BACKSIE                   | DE.  |  |   | ·           |                         |
|   |  |  | ·   |             | ·                       |
|   |  |  |   |             | ·                       |
|   |  | · -  |   |             |                         |
|   | SURVEYOR'S STATEMENT   | **1  |   | ハハンベート      | AND                     |
|   | prepared by me or under my direction in conforct onNovember 2 1, 2012.               | rmance with                                | //نې  | SEMES       | 4                       |
| Signed James                            | Z Hart P.L.S. Number 8657  |  | PROF  | FICEN       | VSE /송                  |
|   | DUNTY SURVEYOR'S STATEMENT   |  | ( <del> </del> *  | No. 8       |                         |
|   | as received November 21, 2012 and 6  | examined                                   |   | Jo 12       | 31/2/2                  |
| and filed <u>Januar</u>                 |  | <i>3</i> , (1), (1)                        |   | E OF CH     | ILIFOR                  |
| Signed Kommu                            | -MH R.C.E. No. 26  | 994  |   | 7500        |                         |
| Title County Surveyo                    | <u>r</u>   |  |   | PROFESS     | NAV                     |
|   |  |  |   | OHKZ        | m. 0 0                  |
| County Surveyor's Cor                   | mment  |  | (8)   | ∾<br>No. 26 | 6994 ( )E)              |
|   |  |  | ( <del>)</del> <del>(</del> <del>)</del> ( <del>)</del> | EXP. 3-     | 31-13 / <del>≩</del> // |
|   |  |  |   | S.C.L.      | 1 2                     |
| (D.D. Sheet No. 16)<br>(Job No. 220820) |  |  |   | E OF CA     | LIFOR                   |

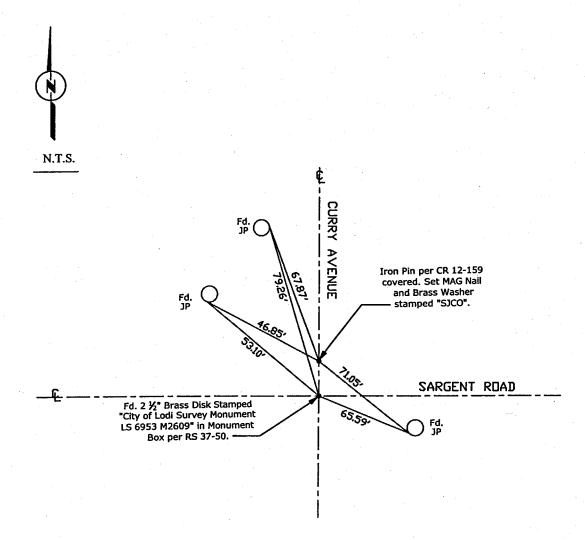

Note: Found Monuments are not tagged unless otherwise noted.

"No Attempt Was Made to Verify the Monument(s)"

Set=Conc. Nail with Brass Washer Stamped
"S.J. Co.", unless otherwise noted
Fd.=Found Conc. Nail with Brass Washer Stamped
"S.J. Co.", unless otherwise noted
CR=Corner Record
FP=Fence Post
JP=Joint Pole
LP=Light Pole
LP=Light Pole
PP=Power Pole
GP=Guy Pole
SP=Service Pole
TP=Telephone Pole
S.F.N.=Searched Found Nothing
N.T.S.=Not To Scale
M&P=Maps & Plats
PM=Parcel Map
RS=Record of Survey
FB=Fleld Book