
CORNER RECORD		Document N	lumber	er CR-12-502		
City of		County of		an Joaquin,	California	
Brief Legal Description _	BECKMAN ROAD 1347' +/- NORTH OF HARNE	Y LANE				
	(WITHIN SECTION 18, TOWNSHIP 3 NORTH, RAI	NGE 7 EAST, MC	NO TAUC	ABLO BASE &	MERIDIAN)	
	CORNER TYPE	N		DINATES (Opt		
	Government Corner	Zone	poch_		□ NAD83 □	
	Date of Survey October 19, 2012	Vert. Da Meas. U	tum:	NGVD29 □		
Corner - Left as fou	und  Found and tagged  Established	☐ Reesto	ıblished	☐ Reb	uilt 🛛	
· ·	of corner found: Evidence used to identify or p	rocedure used	to esta	blish or reesto	ablish the corner:	
SEE SKETCH ON BACKSII			<u> </u>			
	<del></del>				· <del>-</del> ····	
				<del>-</del>	·	
,	· ·					
A description of the phy SEE SKETCH ON BACKSID	ysical condition of the monument as found and DE.	as set or reset:				
	· · · · · · · · · · · · · · · · · · ·					
	SURVEYOR'S STATEMENT				141	
This Corner Record was	prepared by me or under my direction in confe	ormance with		ONAL	E. W.S.	
the Land Surveyors' A				SOMES	74 /2 / M	
Signed Oam	= Z. Hart P.L.S. Number 8657			El line	NSE S	
		<del></del>			8657 / <b>★</b> /	
	OUNTY SURVEYOR'S STATEMENT		//	(2)(f)	121/3/2	
and filed <u>Januar</u>	as received NOVEMBER 30, 2012 and 23, 2013.	examinea		OF C	ALIFOR	
Signed Man	M. Han R.C.E. No. 2	6994		/===		
Title County Surveyo	or			ON AS	SIONAL CAC	
County Surveyor's Co	mment		RFC/C	7/K	16994	
		· · · · · · · · · · · · · · · · · · ·	//*	F \ EXP. 3- パ	-31-13	
(D.D. Sheet No. 16 ) (Job No. 220047)			//	AF OF C	ALIFOR	

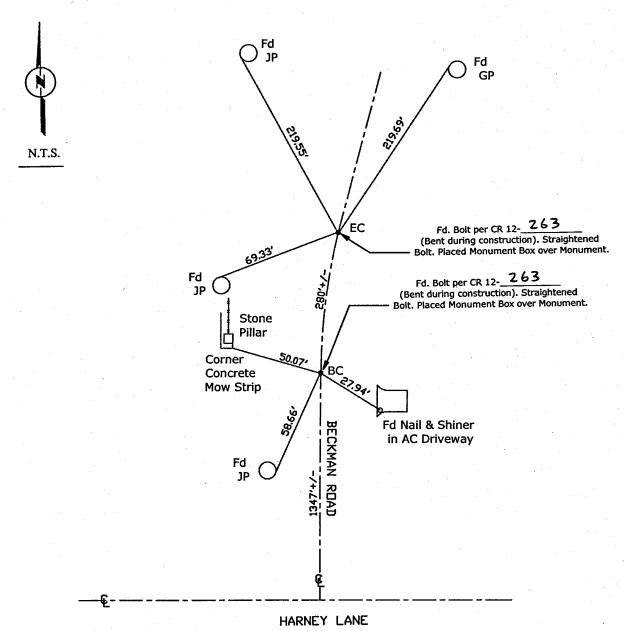

Note: Found Monuments are not tagged unless otherwise noted.

"No Attempt Was Made to Verify the Monument(s)"

Set=Conc. Nail with Brass Washer Stamped
 "S.J. Co.", unless otherwise noted
Fd.=Found Conc. Nail with Brass Washer Stamped
 "S.J. Co.", unless otherwise noted
BC=Beginning of Curve
CR=Corner Record
EC=End of Curve
FP=Fence Post
JP=Joint Pole
LP=Light Pole
LP=Light Pole
LP=Light Pole
SP=Service Pole
GP=Guy Pole
SP=Service Pole
TP=Telephone Pole
S.F.N.=Searched Found Nothing
N.T.S.=Not To Scale
M&P=Maps & Plats
PM=Parcel Map
RS=Record of Survey
FB=Field Book