

CORNER RECO			mber <u>CR-12-508</u>			
Brief Legal Description	COLLIER ROAD @ LOWER SACRAMENTO ROAD	County of	San J	loaquin,	Californic	
	CORNER TYPE	N	COORDINATES (Optional)			
	Government Corner	Zone NAD83	Epoch	NAD2/	□ NAD83 □	
T4N R6E	Date of Survey November 6, 2012	Vert. Do	atum: NG Inits: Me	VD29 □	NAVD88 ☐ Imperial ☒	
Corner - Left as fou	nd ☑ Found and tagged ☐ Established (	☐ Reest	ablished [	] Rebu	vilt 🗆	
Identification and type SEE SKETCH ON BACKSII	of corner found: Evidence used to identify or pro	cedure used	l to establish	n or reesta	blish the corne	
SEE SKEICH ON BACKSIL	JE.			<del></del>		
		_				
·	· · · · · · · · · · · · · · · · · · ·					
SEE SKETCH ON BACKSIE	rsical condition of the monument as found and a DE.					
	SURVEYOR'S STATEMENT				I AAVO	
	prepared by me or under my direction in conformation of the confor	mance with		SONAL SOMES I	E. MASSA	
	E Har P.L.S. Number 8657	<del>,</del>	¥ PRO/	LICE No. {		
	DUNTY SURVEYOR'S STATEMENT			14.	11/2/X	
This Corner Record was and filed Januar	as received <u>DELEMBER 7</u> , 2012 and e	xamined		75 0F C	ALIFOR ALIFORN	
Signed Thomas	M. Fan R.C.E. No. 269	94		٥٢٢٥	\$101	
Title County Surveyo	or			PROFES	M.	
County Surveyor's Co	mment		*REGISSI	No. 2		
			1/3/	EXP. 3-	-31-13 (★)	
(D.D. Sheet No. 12) (Job No. 220062)			1/3	OF C	ALIFORM	

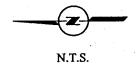

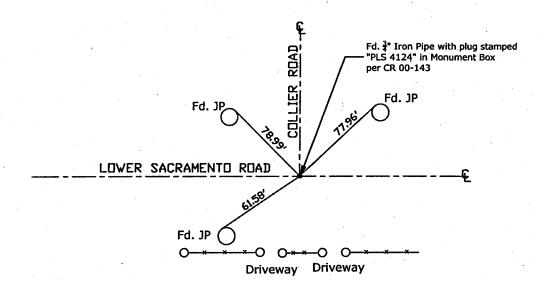

Note: Found Monuments are not tagged unless otherwise noted.

"No Attempt Was Made to Verify the Monument(s)"

Set=Conc. Nail with Brass Washer Stamped

"S.J. Co.", unless otherwise noted
Fd.=Found Conc. Nail with Brass Washer Stamped

"S.J. Co.", unless otherwise noted
CR=Corner Record
FP=Fence Post
JP=Joint Pole
LP=Light Pole
PP=Power Pole
GP=Guy Pole
SP=Service Pole
TP=Telephone Pole
S.F.N.=Searched Found Nothing
N.T.S.=Not To Scale
M&P=Maps & Plats
PM=Parcel Map
RS=Record of Survey
FB=Field Book