

City of San Joaquin. Califor Brief Lagal Description COLUER ROAD 3963* +/- EAST OF LOWER SACRAMENTO ROAD  WITHIN SECTION 12. TOWNSHIP 4 NORTH. RANGE 6 EAST, MOUNT DIABLO BASE & MERIDIAN  CORNER TYPE COORDINATES (Optional)  Government Corner Control Control Cone NAD27 NAD27 NAD28 Property National Reaction National Na	CORNER RECO	)RD	Document Number <u>CR-12-5/0</u>
WITHIN SECTION 12. TOWNSHIP 4 NORTH. RANGE 6 EAST, MOUNT DIABLO BASE & MERIDIAN  CORNER TYPE  COORDINATES (Optional)	City of		
WITHIN SECTION 12. TOWNSHIP 4 NORTH. RANGE 6 EAST, MOUNT DIABLO BASE & MERIDIAN  CORNER TYPE  COORDINATES (Optional)    COORDINATES (Optional)   C	Brief Legal Description _	COLLIER ROAD 3963' +/- EAST OF LOWER SAC	RAMENTO ROAD
Government Corner   Control   E. Control   E. Control   Corner   Control   E. Corner   NaD27   NaD83   NaD83 Epoch   Seek   Corner   NaD83 Epoch   Nad85 Epoch   Nad83 Epoch   Nad85 Epo			
Date of Survey November 6, 2012    Vert. Datum: NGVD29   NAVD88   Imperial   NavD88		Government Corner	N
Identification and type of corner found: Evidence used to identify or procedure used to establish or reestablish the corn SEE SKETCH ON BACKSIDE.  A description of the physical condition of the monument as found and as set or reset:  SEE SKETCH ON BACKSIDE.  SURVEYOR'S STATEMENT  This Corner Record was prepared by me or under my direction in conformance with the Land Surveyors' Act on			Vert. Datum: NGVD29 ☐ NAVD88 ☐
SURVEYOR'S STATEMENT  This Comer Record was prepared by me or under my direction in conformance with the Land Surveyors' Act on	Corner - Left as fou	nd 🛛 Found and tagged 🔲 Established	☐ Reestablished ☐ Rebuilt ☐
SURVEYOR'S STATEMENT  This Corner Record was prepared by me or under my direction in conformance with the Land Surveyors' Act on			occasie used to establish of reestablish me come
SURVEYOR'S STATEMENT  This Corner Record was prepared by me or under my direction in conformance with the Land Surveyors' Act on	<del></del>	<del></del>	+ N
This Corner Record was prepared by me or under my direction in conformance with the Land Surveyors' Act on			
COUNTY SURVEYOR'S STATEMENT  This Corner Record was received DECEMBER 7, 2012 and examined and filed January 23, 2013.  Signed Month R.C.E. No. 26994  Title County Surveyor	the Land Surveyors' Ad	prepared by me or under my direction in confoct on, 2012.	INCENSE 10
This Corner Record was received DECEMBER 7, 2012 and examined and filed January 23, 2013.  Signed R.C.E. No. 26994  Title County Surveyor  Title County Surveyor			
Signed Norman M. Flanc R.C.E. No. 26994  Title County Surveyor  R.C.E. No. 26994  ORDFESSIONAL  ORDF	This Corner Record wo	as received DECEMBER 7, 2012 and 6	
MAS M. CA	Signed Thomas	M. June	3004
County Surveyor's Comment	Title County Surveyo	<u>r</u>	SOMAS M. CI
\'\v\  \\\	County Surveyor's Cor	mment	1186 7/21
(D.D. Sheet No. 12) (Job No. 220062)			CIVIL DE CALLED

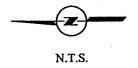

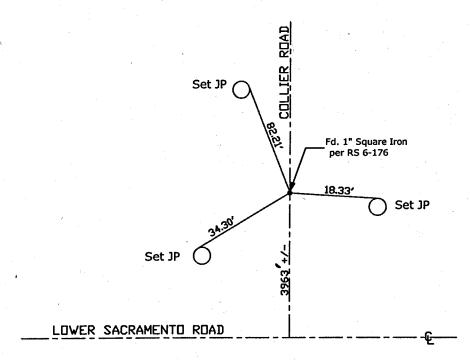

Note: Found Monuments are not tagged unless otherwise noted.

"No Attempt Was Made to Verify the Monument(s)"

Set=Conc. Nail with Brass Washer Stamped
"S.J. Co.", unless otherwise noted
Fd.=Found Conc. Nail with Brass Washer Stamped
"S.J. Co.", unless otherwise noted
CR=Corner Record
FP=Fence Post
JP=Joint Pole
LP=Light Pole
LP=Light Pole
LP=Light Pole
SP=Service Pole
GP=Guy Pole
SP=Service Pole
TP=Telephone Pole
S.F.N.=Searched Found Nothing
N.T.S.=Not To Scale
M&P=Maps & Plats
PM=Parcel Map
RS=Record of Survey
FB=Field Book