
CORNER RECO		Do	cument Num	ber CR	-12	-517
City of		Со	unty of	San Joac		California
Brief Legal Description _	CABE ROAD @ MEL ROAD					
	(WITHIN SECTION 27, TOWNSHIP 2 SOUTH, RANGE 5 EAST)					
	CORNER TYPE		N	ORDINATES	(Optio	onal)
	Government Corner ☐ Control ☐ Meander ☐ Property ☐ Rancho ☐ Other ☒		NAD83 Epo	N. ch	AD27	□ NAD83 □
	Date of Survey December 3, 2012		Vert. Datum Meas. Units:	i: NGVD2	9 🗆	NAVD88 ☐ Imperial 🏻
Corner - Left as fou	and ☐ Found and tagged ☐ Established	d $\square$	Reestablis	hed ⊠	Rebui	ilt 🖂
Identification and type SEE SKETCH ON BACKSII	of corner found: Evidence used to identify or DE.					olish the corner:
	<del></del>	· · ·			,	<u></u>
						1
SEE SKETCH ON BACKSIE	DE.					
	SURVEYOR'S STATEMENT					I AND
This Corner Record was the Land Surveyors' A	prepared by me or under my direction in con	nformar	nce with	24 SE	ES E	1/40/2/
	E Hart P.L.S. Number 8657	· · · · · · ·		1181	LICEN No. 8	
	OUNTY SURVEYOR'S STATEMENT			11/2/10		12/4/
	as received <u><b>DECEMBER 7</b></u> , 2012 and <b>DECEMBER 7</b> , 2013.	d exar	nined	TA PE	0 12 0 CF	311 OR
Signed Man	m. Man R.C.E. No.	26994			$\geq$	
Title County Surveyo	or				OFESS	M. C.
County Surveyor's Co	omment			KEGISSI V	lo. 26	
				M <del>*</del> / FXF	′. 5–.	31–13 (★)
(D.D. Sheet No. 54) (Job No. 220033)				TO THE STATE OF TH	PF CA	LIFOR



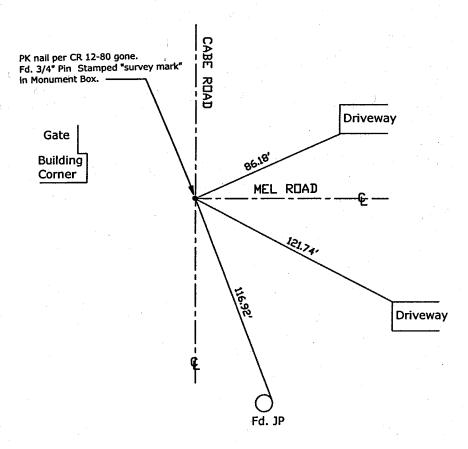

Note: Found Monuments are not tagged unless otherwise noted.

"No Attempt Was Made to Verify the Monument(s)"

Set=Conc. Nail with Brass Washer Stamped
"S.J. Co.", unless otherwise noted
Fd.=Found Conc. Nail with Brass Washer Stamped
"S.J. Co.", unless otherwise noted
CR=Corner Record
FP=Fence Post
JP=Joint Pole
LP=Light Pole
PP=Power Pole
GP=Guy Pole
SP=Service Pole
TP=Telephone Pole
S.F.N.=Searched Found Nothing
N.T.S.=Not To Scale
M&P=Maps & Plats
PM=Parcel Map
RS=Record of Survey
FB=Field Book