
CORNER RECO	ORD	Document Nu	mber CR-1	3-40	
City of		County of	San Joaquin,	California	
Brief Legal Description _	MANTECA ROAD 2640' ± NORTH OF WEST RIP	ON ROAD			
20	CORNER TYPE	C	COORDINATES (Optional)		
	Government Corner ☑ Control □	N E		····	
	Meander □ Property □	Zone	NAD27	□ NAD83 □	
	Rancho 🗆 Other 🗅	Elev	och	<del> </del>	
T2S R7E MDB&M	Date of SurveyJanuary 29, 2013	Vert. Datu Meas. Unit	m: NGVD29 □	NAVD88 □ Imperial ⊠	
123 R/E MUB&M			.,	miponal 23	
Corner - Left as fou	ınd ☑ Found and tagged ☐ Established	☐ Reestable	ished 🔲 Rebi	vilt 🔲	
	of corner found: Evidence used to identify or p	procedure used to	establish or reesto	ablish the corner:	
SEE SKETCH ON BACKSIE	DE.				
			·		
	sical condition of the monument as found and	as set or reset:			
SEE SKETCH ON BACKSIE	DE.				
				·	
	CURVEYORIS STATELAENIT				
This Comments	SURVEYOR'S STATEMENT		JONAL	LAND	
the Land Surveyors' A	prepared by me or under my direction in conf ct on February 15, 2013.	ormance with	STRES	E. Marie	
O.	- 11		18/2	NSE S	
Signed Jamas	E Hart P.L.S. Number 8657	· ·		0007 1.1	
CC	DUNTY SURVEYOR'S STATEMENT		No.	\$65/ <del>*</del>	
This Corner Record we	as received <u>February 15</u> , 2013 and	examined	7 to 12	131/20/	
and filed Nara	h 12, 2013.		OF C	ALIFOR	
Signed Signed	m. Have R.C.E. No. 2	0,000,0			
Title County Surveyo		20774	PROFES	SIONAL	
IIIIe	····		WAS WAS	M.	
County Surveyor's Co	mment			GP (SE)	
			No. 2 EXP. 3-	6994	
			\\ <b>≨</b> \ EXP. 3-	-31-13 /≆//	
			1/2/		
(D.D. Sheet No. 58) (Job No. 220061)			OF O	TIEOS !	
DOD NO. ZZOON				ハいン/	



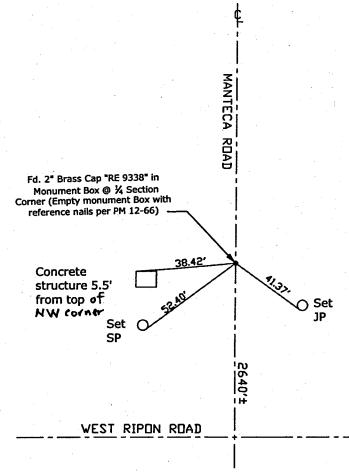

Note: Found Monuments are not tagged unless otherwise noted.

"No Attempt Was Made to Verify the Monument(s)"

Set=Conc. Nail with Brass Washer Stamped
 "S.J. Co.", unless otherwise noted
Fd.=Found Conc. Nail with Brass Washer Stamped
 "S.J. Co.", unless otherwise noted
CR=Corner Record
FP=Fence Post
JP=Joint Pole
LP=Light Pole
LP=Light Pole
PP=Power Pole
GP=Guy Pole
SP=Service Pole
TP=Telephone Pole
S.F.N.=Searched Found Nothing
N.T.S.=Not To Scale
M&P=Maps & Plats
PM=Parcel Map
RS=Record of Survey
FB=Field Book