
CORNER RECORD			Document Number <u>CR-13-44</u>			
City of	· · · · · · · · · · · · · · · · · · ·			n Joaquin,	California	
Brief Legal Description _	MANTECA ROAD 1329'± NORTH OF SEDAN	AVENU	<b>IE</b>			
	CORNER TYPE	· · · · · · · · · · · · · · · · · · ·	COORD	INATES (Opti	ional)	
			N		,	
-	Government Corner		zone	NAD27	□ NAD83 □	
<b></b>	Meander		NAD83 Epoch			
	Rancho 🗆 Other 🗖		Elev Vert. Datum: N	ICVD20 []	NAVD00 🗖	
T2S R7E MDB&M	Date of Survey January 29, 2013			Metric	NAVD88 □ Imperial ☑	
123 K/E MUDOM					_	
Corner - Left as fou	nd 🛛 Found and tagged 🔲 Established	d 🗆	Reestablished	☐ Rebu	vilt 🔲	
Identification and has	of compressional Stideness used to identify or		dura waad ta askah	tiols and a set	L-Cale Alexander	
SEE SKETCH ON BACKSIE	of corner found: Evidence used to identify or				iblish the corner	
JEL SKETCH ON BACKSIE	DE.					
					<del> </del>	
				<del></del>		
SEE SKETCH ON BACKSIE	JC.					
	SURVEYOR'S STATEMENT			NAL	LAND	
This Corner Record was	prepared by me or under my direction in cor	nforma	ince with	SONAL	E. H. Sall	
the Land Surveyors' A	ct on <u>February 15</u> , 2013.		//,4	W/ A/	10 (A)	
Signed James	E Hart P.L.S. Number 8657		PROF	LICE	NSE R	
			- ((i.*	3 N = 3	8657 / <del>*</del> /	
	DUNTY SURVEYOR'S STATEMENT		' //	s) c	13/2/	
	as received <u>February 15</u> , 2013 an	d exa	mined \	7) to 12	311/05/	
and filed Mary	<u>1 17</u> , 2013.			OF C	ALIFO	
Signed Kom	m. Jan R.C.E. No.	26994		OTTO	CIO	
Title County Surveyo	or .			PROFES	310MA/	
				SOMAS	M. CELL	
County Surveyor's Co	mment		([5]		艺[]	
			*REG	No. 2		
				∖ EXP. 3-	·31–13 <i> ¥ </i>	
			. //c			
(D.D. Sheet No. 58)				11/2/2/A	1/2083/	
(Job No. 220061)				Vr C	ALI	



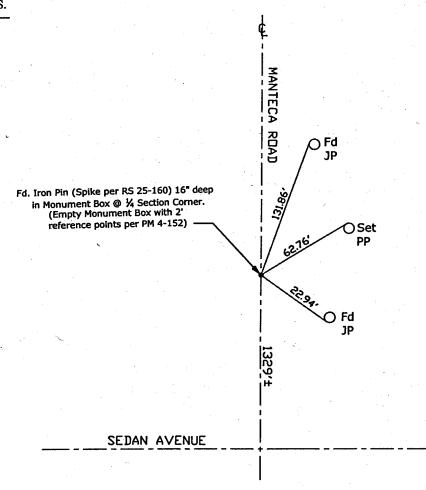

Note: Found Monuments are not tagged unless otherwise noted.

"No Attempt Was Made to Verify the Monument(s)"

Set=Conc. Nail with Brass Washer Stamped
"S.J. Co.", unless otherwise noted
Fd.=Found Conc. Nail with Brass Washer Stamped
"S.J. Co.", unless otherwise noted
CR=Corner Record
FP=Fence Post
JP=Joint Pole
LP=Light Pole
PP=Power Pole
GP=Guy Pole
SP=Service Pole
TP=Telephone Pole
S.F.N.=Searched Found Nothing
N.T.S.=Not To Scale
M&P=Maps & Plats
PM=Parcel Map
RS=Record of Survey
FB=Field Book