
CORNER RECC	ND .		Document Num	ber <u>CR-</u>	3-76
City of			County of	San Joaqui	
Brief Legal Description _	SHELTON ROAD 599' +/- EAST OF ESCALON BELLOTA ROAD				
	(WITHIN SECTION 5, TOWNSHIP 2 NORTH,	RANGE	9 EAST, MOUNT	DIABLO BASE	& MERIDIAN)
	CORNER TYPE	90 51		ORDINATES (	
	Government Corner ☐ Control ☐ Meander ☐ Property ☐ Rancho ☐ Other ☒	]	Zone NAD83 Epoc	NAE ch	027 □ NAD83 □
	Date of Survey March 11, 2013	<del>-</del>	Vert. Datum Meas. Units:	n: NGVD29 Metric	□ NAVD88 □ □ Imperial ☑
	, et, " e		- 1 X X 1		
Corner - Left as fou	nd 🛮 Found and tagged 🔲 Establish	hed [	] Reestablis	hed 🔲 R	Rebuilt
Identification and type SEE SKETCH ON BACKSIE	of corner found: Evidence used to identify DE.		cedure used to	əstablish or re	establish the corner
3			24 - 5		
			2 2 2 2 2 2 2 2 2 2 2 2 2 2 2 2 2 2 2		
ñ "	SURVEYOR'S STATEMENT	35	1 E	ONA	L LAND
This Corner Record was the Land Surveyors' A	prepared by me or under my direction in co ct on, 2013.	conform	nance with	STATE STATE	S E. WALE
Signed James of	P.L.S. Number 86:	57	<del></del>		ICENSE o. 8657 ★
	as received March 14 , 2013 of 14 , 2013 of 14 , 2013.		A	A TE OF	12 31 3 CALIFORE
Signed	R.C.E. No	i. <u>2699</u>	94	PRO	ESSIONAL
County Surveyor's Co	mment	11	()	SE SON'S	. 26994 . 711 15
					. 26994 3-31-15 ★
(D.D. Sheet No. 23) (Job No. 220045)		9		TF OF	CALIFOR



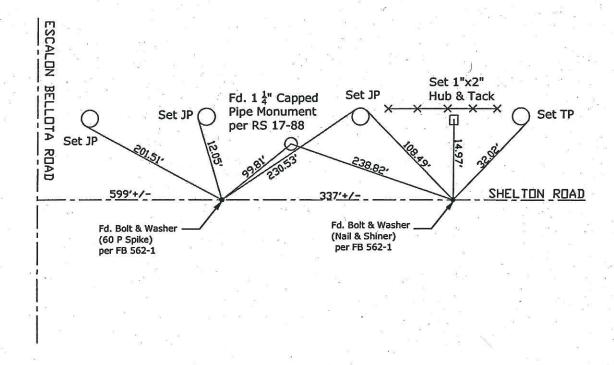

Note: Found Monuments are not tagged unless otherwise noted.

"No Attempt Was Made to Verify the Monument(s)"

Set=Conc. Nail with Brass Washer Stamped
"S.J. Co.", unless otherwise noted
Fd.=Found Conc. Nail with Brass Washer Stamped
"S.J. Co.", unless otherwise noted
CR=Corner Record
FP=Fence Post
JP=Joint Pole
LP=Light Pole
LP=Light Pole
PP=Power Pole
GP=Guy Pole
SP=Service Pole
TP=Telephone Pole
S.F.N.=Searched Found Nothing
N.T.S.=Not To Scale
M&P=Maps & Plats
PM=Parcel Map
RS=Record of Survey
FB=Field Book