
CORNER RECORD		Docum	nent Numb	oer_CR-13-204	
City of	•	Count	y of	San Joaquin,	California
Brief Legal DescriptionLAMMERS ROAD .	1/2 MILE +/- SOUTH OF VALPI	ICO ROAI	)	104	
C	ORNER TYPE	N		RDINATES (OF	otional)
Government Corr	ner 🖾 Control 🗆	E			7 🗆 NAD83 🗖
Meander	□ Property □	Zo	ne N83 Fooch	NAD2	7 🗆 NAD83 🗖
Rancho	☐ Other ☐	Ele	ev		
T3S R5E Date of Survey	May 30, 2013		ert. Datum: eas. Units:	NGVD29 E Metric E	
MDB&M			was constructed and		
Corner - Left as found  Found and	tagged   Established		Reestablish	ed 🛛 Re	built 🗆
dentification and type of corner found: Evid SEE SKETCH ON BACKSIDE.	x x	3			
	· ·				
					*
		×5		a and the same and the same	
		A	V		
	*		2		
CUDVEYODIS CTAT		H			1 44
SURVEYOR'S STAT		, L Formanos	. voith	ONAL	FANOS
This Corner Record was prepared by me or the Land Surveyors' Act onJun	ie 6, 2013.	ionnance	· WIIII	SINES	- 19 (2)
$\cap$ - $\sim$	P.L.S. Number <u>8657</u>	S =		18 ° 11	CENSE 完
Signed James Plant	F.L.3. NUTTIDET6637	± 85			. 8657 / <del>*</del>
COUNTY SURVEYOR'S			· · ·	1/02/02	113/2/
This Corner Record was received 100	# #	d examin	ed	Washing.	12/31/08
and filed 4/4	, 2013.			OF	CALIFO
Signed from M. Har	R.C.E. No	26994		705	ESSION
Title County Surveyor	¥ .		865 F87	PRUF	ESSIONAL ES
			29	A MOSE	". C.C.
County Surveyor's Comment		2		188/2	26994
	5 4 4	:			26994 3-31-15 ★
				1/2/	\Z/
(D.D. Sheet No. 69)			-	May CI	VILA
(Job No. 220071 )		9	la <sub>na</sub>	OF	CALIF

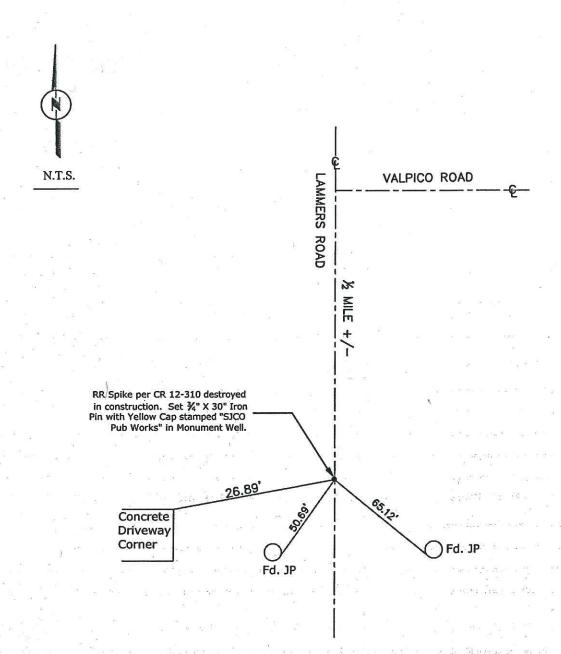

Note: Found Monuments are not tagged unless otherwise noted.

"No Attempt Was Made to Verify the Monument(s)"

Set=Conc. Nail with Brass Washer Stamped
"S.J. Co.", unless otherwise noted
Fd.=Found Conc. Nail with Brass Washer Stamped
"S.J. Co.", unless otherwise noted
CR=Corner Record
FP=Fence Post
JP=Joint Pole
LP=Light Pole
PP=Power Pole
GP=Guy Pole
SP=Service Pole
TP=Telephone Pole
S.F.N.=Searched Found Nothing
N.T.S.=Not To Scale
M&P=Maps & Plats
PM=Parcel Map
RS=Record of Survey
FB=Field Book