
City of	CORNER RECORD					Document Number CR-14-10					
5 40 62 4						nty of		n Joaqı		Cal	iforı
Brief Legal Description _	LIVE OAK ROAD - 7,	200' ± E/	AST OF STA	TE HIGH	WAY 8	38	3				
	CORNER TYPE				COORDINATES (Optional) N						
	Government Corne	r 🔯	Control			N E.					
25	Meander Come		Property			E Zone					
ZU	Rancho		Other			NAD83 Epo	och				
						Elev Vert. Datur		NGVD29	9 🗆	NAVD8	8 [
T3N R7E MDB&M	Date of Survey	Decemi	per 12, 201	3		Meas. Units	s: <i>N</i>	Metric		Imperia	[2
Corner - Left as four	nd 🛭 Found and to	gged	☐ Esta	blished		Reestabli	ished		Rebu	ıilt 🗆	
				196		0.000					8 1
Identification and type of SEE SKETCH ON BACKSID									eesto	iblish the	con
, N											
N N N N N N N N N N N N N N N N N N N					S		9			-	
		7114	14								
	26 2										
					(c)	e e		8	10	- 1. E	
		2				30	100				7
	Si .					•12					
	SURVEYOR'S STATEA	MENT	1 a			118. V.			AL	LAND	//
This Corner Record was p	orepared by me or ur	nder my		3.0	rman	ce with		(5)	AL	LAND S E. HAD	
This Corner Record was p	orepared by me or ur	nder my	direction , 2014	3.0	rman	ce with		10 X	AL	LAND S E. HAR	1/2
This Corner Record was rethe Land Surveyors' Ac	orepared by me or ur	nder my ary 3		, § ,	rman	ce with	PROG	4/2	LICE	E. HAP	
This Corner Record was parties the Land Surveyors' Action of Signed Tames	orepared by me or ur	nder my ary 3 P.L.S. N	, 2014 Number	, § ,	rman	ce with		4/2	LICE	E. HAP	
This Corner Record was parties the Land Surveyors' Action Signed Signed CO	orepared by me or unstance or	nder my pary 3 P.L.S. N	, 2014 Number ENT	8657				4/2	LICE	E. HAP	
This Corner Record was parties Land Surveyors' Action Signed CO This Corner Record was parties to the corner Record was parties to t	orepared by me or uncert onFebruary UNTY SURVEYOR'S Sus received _February	nder my pary 3 P.L.S. N	, 2014 Number_ ENT 3, 20	8657				4/2	LICE	E. HAP	
This Corner Record was possible Land Surveyors' Action Signed Control of this Corner Record was possible to the Land filed Ebysia	orepared by me or uncert onFebruary UNTY SURVEYOR'S Sus received _February	P.L.S. N	, 2014 Number_ ENT 3, 20	8657	exam			SATE OF THE PERSON OF THE PERS	LICE No.	E. HAP	
This Corner Record was parties Land Surveyors' Action Signed Tames CO This Corner Record was parties and filed Ebrua Signed Temps	prepared by me or unit on February SURVEYOR'S STREET FROM 14	P.L.S. N	, 2014 Number_ ENT 3, 20	8657 14 and (exam			STATE OF THE PERSON OF THE PER	LICE No.	ENSE 8657 PALIFO	1/2
This Corner Record was parties Land Surveyors' Action Signed Tames CO This Corner Record was parties and filed Ebrua Signed Temps	prepared by me or unit on February SURVEYOR'S STREET FROM 14	P.L.S. N	, 2014 Number_ ENT 3, 20	8657 14 and (exam			STATE OF THE PERSON OF THE PER	LICE No.	ENSE 8657 PALIFO	Ser
This Corner Record was parties Land Surveyors' Action Signed CO. This Corner Record was partied Ebruary Signed February Signed County Surveyor	prepared by me or uncert onFebruary SURVEYOR'S STREET February 14	P.L.S. N	, 2014 Number_ ENT 3, 20	8657 14 and (exam			TO STATE OF THE ST	LICE No.	E. HARP SSIONAL M. GY	Ser
This Corner Record was parties Land Surveyors' Action Signed CO. This Corner Record was partied Ebruary Signed February Signed County Surveyor	prepared by me or uncert onFebruary SURVEYOR'S STREET February 14	P.L.S. N	, 2014 Number_ ENT 3, 20	8657 14 and (exam			SALL SALL	LICE No.	E. HAP ENSE 8657 PALIFO SSIONAL M. GY 26994	
This Corner Record was parties Land Surveyors' Action Signed CO This Corner Record was parties to the corner Record was parties to t	prepared by me or uncert onFebruary SURVEYOR'S STREET February 14	P.L.S. N	, 2014 Number_ ENT 3, 20	8657 14 and (exam			SALL SALL	LICE No.	E. HARP SSIONAL M. GY	
This Corner Record was parties Land Surveyors' Action Signed CO. This Corner Record was partied Ebruary Signed February Signed County Surveyor	prepared by me or uncert onFebruary SURVEYOR'S STREET February 14	P.L.S. N	, 2014 Number_ ENT 3, 20	8657 14 and (exam			SALL SALL	LICE No.	E. HAP ENSE 8657 PALIFO SSIONAL M. GY 26994	



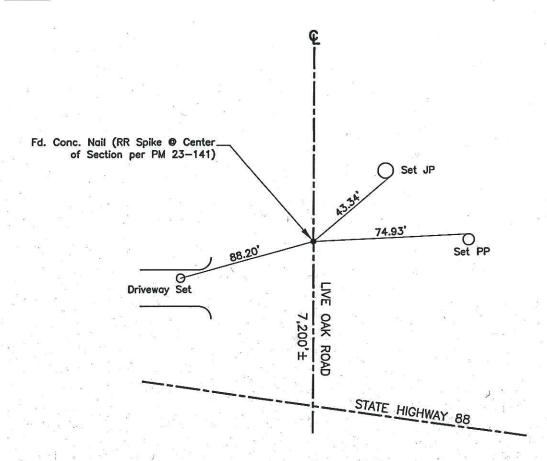

Note: Found Monuments are not tagged unless otherwise noted.

"No Attempt Was Made to Verify the Monument(s)"

Set=Conc. Nail with Brass Washer Stamped
"S.J. Co.", unless otherwise noted
Fd.=Found Conc. Nail with Brass Washer Stamped
"S.J. Co.", unless otherwise noted
CR=Corner Record
FP=Fence Post
JP=Joint Pole
LP=Light Pole
LP=Light Pole
PP=Power Pole
GP=Guy Pole
SP=Service Pole
TP=Telephone Pole
S.F.N.=Searched Found Nothing
N.T.S.=Not To Scale
M&P=Maps & Plats
PM=Parcel Map
RS=Record of Survey
FB=Field Book