
CORNER RECORD			Document Number _ CR-14-210			
City of		County		San Joaquin,	California	
Brief Legal Description_	TOKAY COLONY ROAD 1320' ± EAST OF	JACK TONE RO	AD			
(Within Section 30	, Township 3 North, Range 8 East, Mount	Diablo Base & M	eridian)			
	CORNER TYPE		COORDINATES (Optional) N			
	Government Corner   Control	☐ E				
	Meander 🗆 Property	n Zon	e	NAD27	□ NAD83 □	
	Rancho 🗆 Other	Elev	·			
	Date of SurveyJuly 01, 2014			NGVD29 ☐ Metric ☐	NAVD88 □ Imperial ☒	
8 9					00	
Corner - Left as fou	nd 🛛 Found and tagged 🗌 🛮 Estab	lished 🔲 . Re	establish	ed 🔲 Reb	uilt 🔲	
1 <del>770 - 1780 - 1</del>	5 0 II		11			
Identification and type	of corner found: Evidence used to identit	y or procedure u	used to es	tablish or reesto	ablish the corner	
SEE SKETCH ON BACKSIE						
		*			16	
				- V		
·		B 1 1 1 1 1 1 1 1 1 1 1 1 1 1 1 1 1 1 1			-	
A description of the phy	rsical condition of the monument as foun	d and as set or re	eset:		-	
SEE SKETCH ON BACKSIE					00	
				**************************************		
	a e					
	SURVEYOR'S STATEMENT			ONAL	LAND	
	prepared by me or under my direction in	n conformance w	/ith	SOMES	E. 4/2/2	
	ct on, 2014			1101	7	
Signed Jamo	P.L.S. Number	8657			ENSE OF	
CC	DUNTY SURVEYOR'S STATEMENT			NO.	8657	
This Corner Record w	as received <u>September 8</u> , 201	14 and examine	ed	1 x to 1	0/31/201	
and filed Septem	nber 26 , 2014.		ti.	OF	CALIFOR	
Signed Tham	aM. Jan R.C.E.	No. <u>26994</u>				
Title County Surveyo			<del></del>	PROFE.	SSIONAL	
				WAS	M.	
County Surveyor's Co	mment			15/2	ZZ	
					26994 -31-15 ★	
			w)	EXP. 3	-31-15	
(D.D. Ch111 12 )	n e e e e e e e e e e e e e e e e e e e			10 A C 1		
(D.D. Sheet No. 18 ) (Job No. 544002)	, ,			WE OF (	CALIFOX	

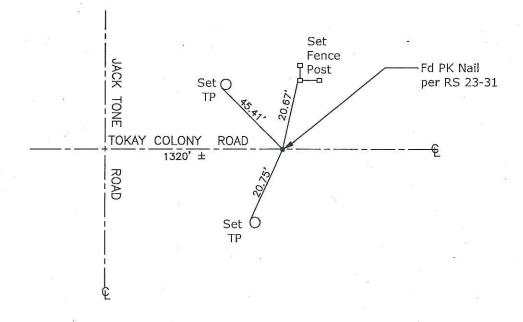

N.T.S.



Note: Found Monuments are not tagged unless otherwise noted.

"No Attempt Was Made to Verify the Monument(s)"

Set=Conc. Nail with Brass Washer Stamped
"S.J. Co.", unless otherwise noted
Fd.=Found Conc. Nail with Brass Washer Stamped
"S.J. Co.", unless otherwise noted
CR=Corner Record
FP=Fence Post
JP=Joint Pole
LP=Light Pole
PP=Power Pole
GP=Guy Pole
SP=Service Pole
TP=Telephone Pole
S.F.N.=Searched Found Nothing
N.T.S.=Not To Scale
M&P=Maps & Plats
PM=Parcel Map
RS=Record of Survey
FB=Field Book