
CORNER RECORD		Document Number <u>CR-16-357</u>		
City of		County of	San Joaqui	in, California
Brief Legal Description_	WILLOW AVENUE @ ASH LANE			
	(Within Section 10, Township 2 South, Range 6	East, Mount Dic	ıblo Base & Mer	idian )
<i>y</i>	CORNER TYPE		COORDINATES (	
	Government Corner ☐ Control ☐	N E.		
	Meander	Zone	NAI	D27 🗆 NAD83 🗆
	Rancho □ Other ⊠	NAD83 E <sub>l</sub> Elev		
	Date of Survey July 13, 2016		um: NGVD29	□ NAVD88 □ □ Imperial ☑
Corner - Left as fou	nd ⊠ Found and tagged □ Established	☐ Reesta	blished 🔲 I	Rebuilt 🗆
	of corner found: Evidence used to identify or p	orocedure used	to establish or re	eestablish the corne
SEE SKETCH ON BACKSII	DE.			
		100000000000000000000000000000000000000		
<del></del>				
A description of the ph	ysical condition of the monument as found an	d as set or reset		1,000
SEE SKETCH ON BACKSII		d as set of leset	<del>'</del>	**************************************
oll of the property			2	2 0
				N. (C.E.)
	SURVEYOR'S STATEMENT		/aN	AL LAND
	prepared by me or under my direction in con act on	formance with	Z Z Z	ES E. HAPPE
	Z. Hart P.L.S. Number 8657		[[8]	LICENSE R
				Vo. 8657 /★
	OUNTY SURVEYOR'S STATEMENT		10/0	
	vas received July 21, 2016 and	d examined		12 31
and filedA	1gust 19 , 2016.		11.0	FCALIFO
Signed Www	P.L.S. No.	4842		
Title County S	urveyor		NOW	AL LAND
			15/6	M D. Sign
County Surveyor's Co	omment		15/5	W TIE
<u> </u>	A STATE OF THE STA		PRO	LICENSE TIP
			/ <del>*</del> / /	No. 4842
(D.D. Sheet No. 57)			103	
(Job No. 221609)			11/60	F CALIFOX



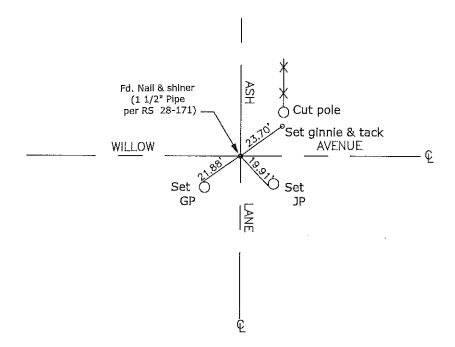

Note: Found Monuments are not tagged unless otherwise noted.

"No Attempt Was Made to Verify the Monument(s)"

Set=Conc. Nail with Brass Washer Stamped
"S.J. Co.", unless otherwise noted
Fd.=Found Conc. Nail with Brass Washer Stamped
"S.J. Co.", unless otherwise noted
CR=Corner Record
FP=Fence Post
JP=Joint Pole
LP=Light Pole
LP=Light Pole
PP=Power Pole
GP=Guy Pole
SP=Service Pole
TP=Telephone Pole
S.F.N.=Searched Found Nothing
N.T.S.=Not To Scale
M&P=Maps & Plats
PM=Parcel Map
RS=Record of Survey
FB=Field Book