

U.S. BUREAU OF RECLAMATION

SECTION (5) CORNER TIE TAG

T. 4 S., R. 6 E., MDB&M, Section 5, East 1/4 Corner

Ties by U.S.B.R., Date 8-28-1984 Monument Set by _____ Date _____

DESCRIPTION OF MONUMENTS: CONCRETE MONUMENT WITH NAIL

VERTICAL LOCATION: 26" DEEP (SET 2X2 HUB FLUSH 8-28-84)

SWING TIES

20.29' N.W. OF SHINER ON S. SIDE JUNCTION


POWER POLE.

18.0' W. OF N.S. POWERLINE

22.6' N. OF E.W. POWERLINE

78.48 N.W. OF SHINER ON N. SIDE TRANSFORMER POLE

120.74 S.W. OF 'X' ON N. SIDE 42" CONC. STANDPIPE

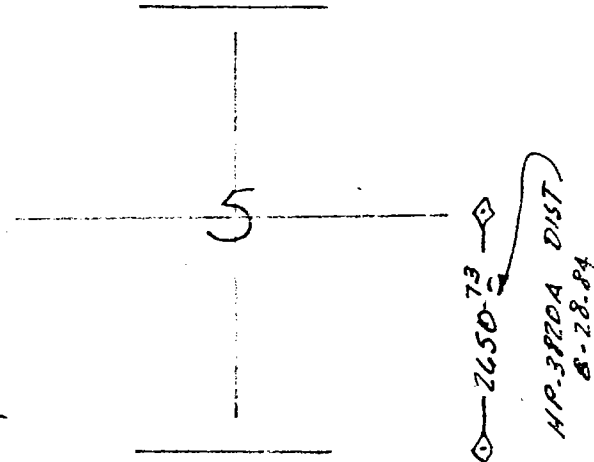

U.S. BUREAU OF RECLAMATION

SECTION (8) CORNER TIE TAG

T. 4 S., R. 6 E., MDB&M, Section 8, N.E. Corner

Ties by U.S.B.R., Date 8-28-1984 Monument Set by _____ Date _____

DESCRIPTION OF MONUMENTS: CONCRETE MONUMENT WITH BRASS PLATE

VERTICAL LOCATION: 12" DEEP (SET HUB 3" DEEP 8-28-1984)

SWING TIES

16.35' S.W. OF SHINER ON N. SIDE

OF POWER POLE.


16.0' W. OF N.S. POWER LINE.

36.54' N.W. OF 'X' ON N. SIDE OF

METAL STANDPIPE.

40.72' N.E. OF SHINER ON W. SIDE

OF GATE POST.

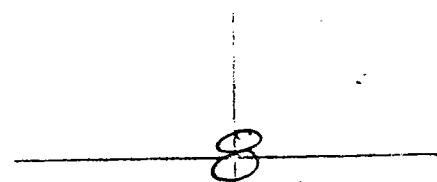

COUNTY SURVEYOR'S CERTIFICATE

THE CORNER RECORD WAS RECEIVED Sept. 10, 1984

AND EXAMINED AND FILED Sept. 12, 1984

BY: Robert D. Williams

TITLE: Chief Deputy County Surveyor

DOCUMENT No. CR-84-001