


# CORNER RECORD

Document Number CR-14-106

City of \_\_\_\_\_

County of San Joaquin, California

Brief Legal Description Line between Set 3/4" Iron Pipe and Point "107A", as shown on R.S. 37-126

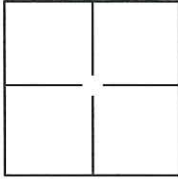

### CORNER TYPE

Government Corner  Control   
 Meander  Property   
 Rancho  Other

### COORDINATES(Optional)

N. \_\_\_\_\_  
 E. \_\_\_\_\_  
 Zone \_\_\_\_\_ NAD27  NAD83   
 NAD83 Epoch \_\_\_\_\_  
 Elev. \_\_\_\_\_  
 Vert. Datum: NGVD29  NADV88   
 Meas. Units: Metric  Imperial

Portion of Projected Sec. 11 and 12  
T.1S., R.5E., M.D.B. & M.

Date of Survey May 10, 2014

Corner - Left as found  Found and tagged  Established  Reestablished  Rebuilt

Identification and type of corner found: Evidence used to identify or procedure used to establish or reestablish the corner:

See Sheet 2

A description of the physical condition of the monument as found and as set or reset: \_\_\_\_\_

See Sheet 2

### SURVEYOR'S STATEMENT

This Corner Record was prepared by me or under my direction in conformance with the Land Surveyor's Act on May 21, 2014.

Signed Michael L. Quartacci P.L.S. or R.C.E. No.: \_\_\_\_\_ L.S. 4450




### COUNTY SURVEYOR'S STATEMENT

This Corner Record was received May 23, 2014 and examined and filed June 13, 2014.

Signed Thomas M. Gau P.L.S. or R.C.E. No.: 26994

Title County Surveyor

County Surveyor's Comment \_\_\_\_\_

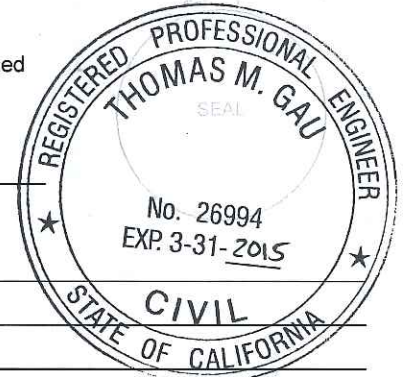

# WING LEVEE ROAD

## BASIS OF BEARINGS

THE BASIS OF BEARINGS FOR THIS SURVEY IS THE LINE BETWEEN THE SET 3/4" PIPE AND POINT "107A", SHOWN ON R.S. 37-126, S.J.C.R., AS EAST.

## LEGEND



- INDICATES FOUND MONUMENT AS NOTED
- INDICATES SET 3/4" X 30" IRON PIPE W/PLASTIC CAP STAMPED L.S. 4450
- FD. INDICATES FOUND ON THIS SURVEY
- (M) INDICATES MEASURED THIS SURVEY
- I.N. INDICATES INSTRUMENT NUMBER, S.J.C.R.
- DOC. NO. INDICATES DOCUMENT NUMBER, S.J.C.R.
- R.S. INDICATES RECORD OF SURVEY, BOOK AND PAGE, S.J.C.R.
- S.J.C.R. INDICATES SAN JOAQUIN COUNTY RECORDS

## REFERENCE

(A) R.S. 37-126, S.J.C.R.

## LINE TABLE

LINE	BEARING	DISTANCE
L1	EAST(M)(A)	46.00'(M)

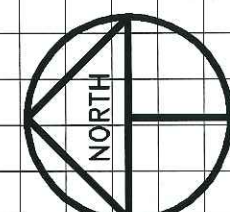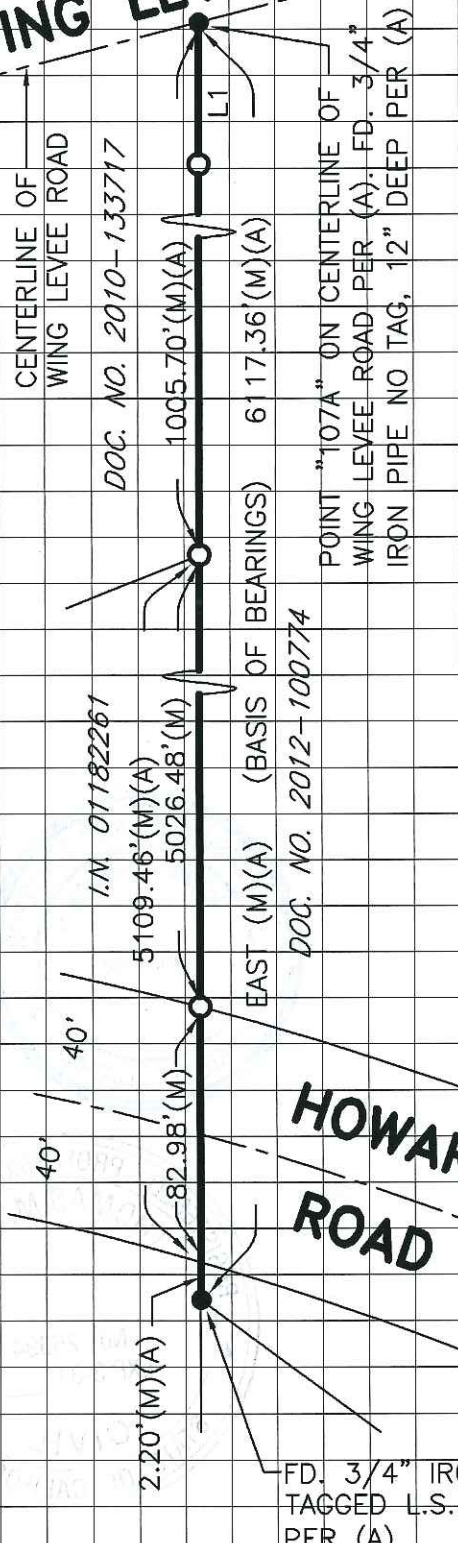

SCALE: 1" = 60'  
2014-115

R.S. 37-126