


CORNER RECORD

City of _____

Document Number CR-14-44
County of San Joaquin, California

Brief Legal Description PRINCETON AVENUE - EAST OF KIRK AVENUE

(WITHIN SECTION 32, TOWNSHIP 2 NORTH, RANGE 6 EAST, MOUNT DIABLO BASE & MERIDIAN)

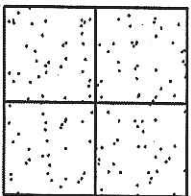

CORNER TYPE

Government Corner Control
Meander Property
Rancho Other

Date of Survey OCTOBER 4, 2013

COORDINATES (Optional)

N. _____
E. _____
Zone _____ NAD27 NAD83
NAD83 Epoch _____
Elev. _____
Vert. Datum: NGVD29 NAVD88
Meas. Units: Metric Imperial

Corner - Left as found Found and tagged Established Reestablished Rebuilt

Identification and type of corner found: Evidence used to identify or procedure used to establish or reestablish the corner:
SEE SKETCH ON BACKSIDE.

A description of the physical condition of the monument as found and as set or reset:
SEE SKETCH ON BACKSIDE.

SURVEYOR'S STATEMENT

This Corner Record was prepared by me or under my direction in conformance with the Land Surveyors' Act on FEBRUARY 25, 2014.

Signed James E. Hart P.L.S. Number 8657

COUNTY SURVEYOR'S STATEMENT

This Corner Record was received February 28, 2014 and examined and filed March 12, 2014.

Signed Thomas M. Gau R.C.E. No. 26994

Title County Surveyor

County Surveyor's Comment _____

(D.D. Sheet No. 30A)
(Job No. 220034)





N.T.S.

Fd. Chiseled "←"
on Sidewalk 555' East of
Delano Ave.

Fd. Chiseled "←"
on Sidewalk

Fd. Chiseled "←"
on Sidewalk
ADDRESS
2735

Chiseled "←"
on Sidewalk 230' East of
Delano Ave gone. Set
Chiseled "←" per
CR-13-308
ADDRESS
2745

Fd. Chiseled "←"
on Sidewalk
ADDRESS
2745

Fd. Chiseled "←"
on Sidewalk
ADDRESS
2827

Chiseled "←"
on Sidewalk 750' East of
Kirk Ave gone. Set
Chiseled "←" per
CR-13-308
ADDRESS
2837

Fd. Chiseled "←"
on Sidewalk

Fd. Chiseled "←"
on Sidewalk
ADDRESS
2905

Chiseled "←"
on Sidewalk 425' East of
Kirk Ave gone. Set
Chiseled "←" per
CR-13-308

ADDRESS (FB. 704)
2658
Chiseled "←" on Sidewalk
555' East of Delano Ave gone.
Set Chiseled "←" per CR-13-308


ADDRESS
2668
Fd. Chiseled "←"
on Sidewalk

Fd. Chiseled "←"
on Sidewalk

Fd. Chiseled "←"
on Sidewalk

Fd. Chiseled "←"
on Sidewalk

Fd. Chiseled "←"
on Sidewalk

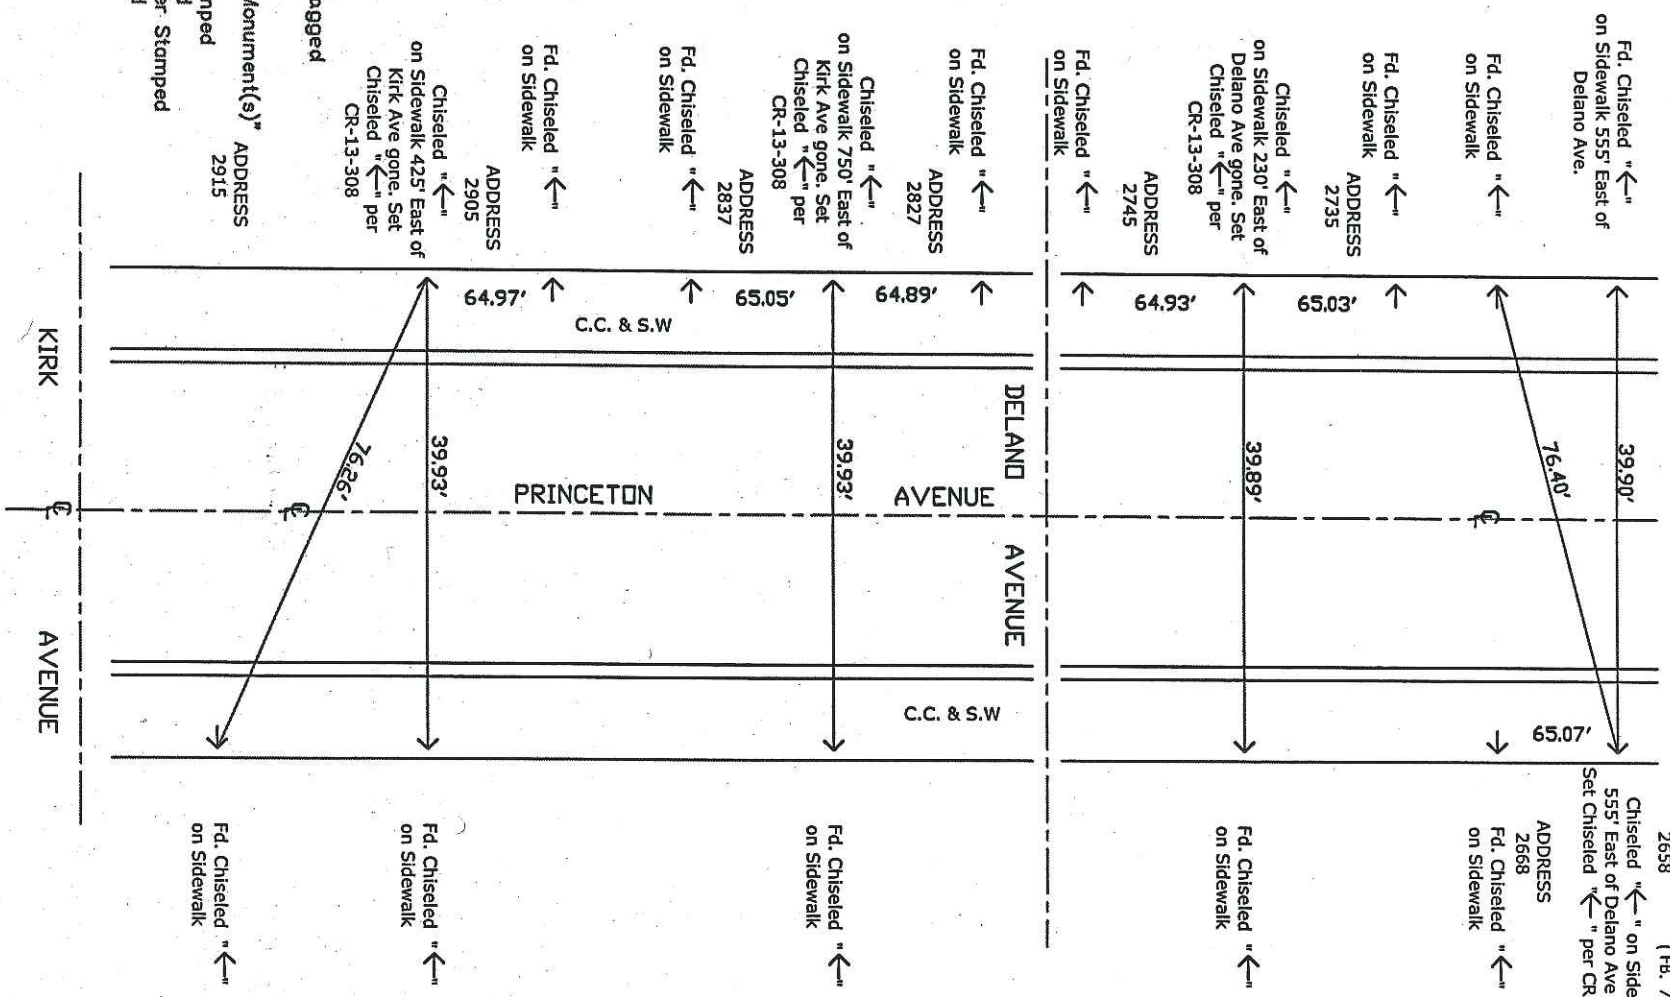

Note: Found Monuments are not tagged unless otherwise noted.

"No Attempt Was Made to Verify the Monument(s)" ADDRESS 2915

Set=Conc. Nail with Brass Washer Stamped

S.J. Co., unless otherwise noted

Fd.=Found Conc. Nail with Brass Washer Stamped

S.J. Co., unless otherwise noted

FP=Fence Post

JP=Joint Pole

LP=Light Pole

PP=Power Pole

GP=Guy Pole

SP=Service Pole

TP=Telephone Pole

S.F.N.=Searched Found Nothing

N.T.S.=Not To Scale

M&P=Maps & Plats

PM=Parcel Map

RS=Record of Survey

FB=Field Book

C.C. & S.W. = Conc. Curb. and Side Walk